

Washington-
G 103
6-69

MISSISSIPPI
BOARD OF WATER COMMISSIONERS
416 North State Street
Jackson, Mississippi 39201

CODED

WATER WELL DRILLERS LOG

4 June 69 19 LHW Pump & Water Serv. Wash
date well completed firm name county well located

LANDOWNER: Ralph Smith
High 82 W.
Greenville, Miss.
(mailing address)

description of formations encountered	from	to
Clay	0	17
Sand	17	70
Sand & gravel	70	88
Rock	88	89
Clay	89	180
Sand & Clay st	180	240

WELL LOCATION:
sec. 18 T. 17 N R. 9 W
7 miles S/W of Greenville
(distance) (direction) (nearest town)

WELL PURPOSE: home
(home, irrigation, municipal, industrial)

WELL COMPLETION DATA:
(1) diameter (inches) 2
(2) total depth (feet) _____
(3) static water level (feet) _____ below above top of ground.
(4) casing Galv. 375
(material) (depth)
(size) if telescope see back.
(5) screen 10 375
(length) (depth to top)
2" SS
(size) (material)
(6) pump 1 1100/hy
(HP) (yield gpm)
Elect
(type power)
(7) electric log _____
(yes or no)
(organization running log) _____
(8) how well bottom plugged back wash valve.


DRILLERS REMARKS: _____

JUL 14 1969

MISSISSIPPI
BOARD OF
WATER COMMISSIONERS

If well telescopes please sketch and show depths.

GROUND LEVEL

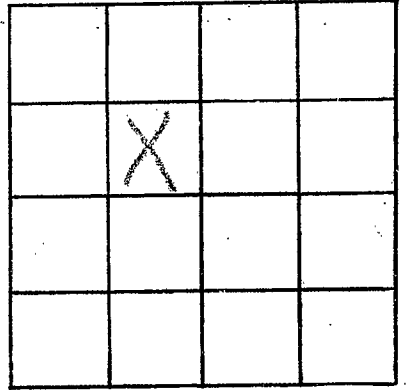

SECTION 16

Please indicate well location X.

ADDITIONAL INFORMATION

If more than one screen, show locations of each on sketch.