

CODED

11/20/69
JH

WASHINGTON
G 105,
6-30-69

MISSISSIPPI
BOARD OF WATER COMMISSIONERS
416 North State Street
Jackson, Mississippi 39201

WATER WELL DRILLERS LOG

C2938

June 30, 19 69 Layne-Central Company Washington
date well completed firm name county well located

LANDOWNER: W. C. Skates, Jr.

description of formations encountered

from to

Clay 0 57
Coarse sand 57 76
Coarse sand, pea gravel 76 96

Avon, Mississippi
(mailing address)

WELL LOCATION:

sec. 37 T 17 N R 8 W
4 miles west of Wayside
(distance) (direction) (nearest town)

WELL PURPOSE: irrigation
(home, irrigation, municipal, industrial)

WELL COMPLETION DATA:

- (1) diameter (inches) 16
- (2) total depth (feet) 94
- (3) static water level (feet) 15' 11" below top of ground.
- (4) casing steel, 64' (material), (depth)
16" If telescope see back. (size)
- (5) screen 30', 94' (length), (depth to top)
16", Armco (size), (material)
- (6) pump 50, 2400 (HP), (yield gpm)
electric (type power)
- (7) electric log no (yes or no)
(organization running log)
- (8) how well bottom plugged plate


NOV 28 1969

DRILLERS REMARKS:

MISS. Bd. OF
WATER COMM.

If well telescopes please sketch and show depths.

GROUND LEVEL

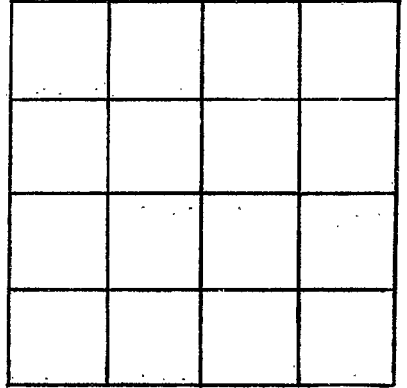

SECTION _____

Please indicate well location X.

ADDITIONAL INFORMATION

If more than one screen,
show locations of each on sketch.