

CODED

CODED 7/23/68
C 2671
CODED

Washington
G 1106
5-34-68

MISSISSIPPI
BOARD OF WATER COMMISSIONERS
416 North State Street
Jackson, Mississippi 39201
WATER WELL DRILLERS LOG

May 24, 19 68 Layne-Central Company Washington
date well completed firm name county well located


LANDOWNER: <u>Hubert Robertson</u>	description of fomations encountered	from	to
	Clay	0	20
	Clay balls	20	44
<u>Indianola, Mississippi</u> (mailing address)	Clay balls, fine sand	44	52
	Coarse sand, pea gravel	52	84
	Clay		84
WELL LOCATION:			
sec. <u>21</u> T. <u>17</u> N. R. <u>8</u> E W			
<u>6</u> miles <u>south</u> of <u>Greenville</u> (distance) (direction) (nearest town)			
WELL PURPOSE: <u>irrigation</u> (home, irrigation, municipal, industrial)			
WELL COMPLETION DATA:			
(1) diameter (inches) <u>16</u>			
(2) total depth (feet) <u>84</u>			
(3) static water level (feet) <u>18'</u> <u>below</u> <u>above</u> top of ground.			
(4) casing <u>steel</u> , <u>54'</u> (material) (depth)			
<u>16"</u> if telescope see back. (size)			
(5) screen <u>30'</u> , <u>84'</u> (length) (depth to top)			
<u>16"</u> , <u>Armco</u> (size) (material)			
(6) pump <u>30</u> <u>1500</u> (HP) (yield gpm)			
<u>engine</u> (type power)			
(7) electric log <u>no</u> (yes or no)			
<u></u> (organization running log)			
(8) how well bottom plugged <u>plate</u>			

DRILLERS REMARKS:

MISSISSIPPI
STATE BOARD OF
WATER COMMISSIONERS
JUL 23 1968

If well telescopes please sketch and show depths.

GROUND LEVEL

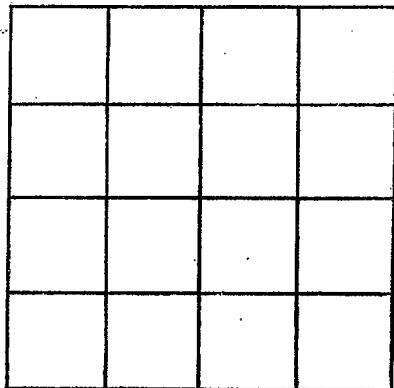

SECTION _____

Please indicate well location X.

ADDITIONAL INFORMATION

If more than one screen,
show locations of each on sketch.