

Washington
G 108
3-23-70

MISSISSIPPI
BOARD OF WATER COMMISSIONERS
416 North State Street
Jackson, Mississippi 39201

CODED

WATER WELL DRILLERS LOG

3-23 1970 date well completed
Waste Well Drilling Co firm name
Washington county well located

LANDOWNER: L. R. Rodgers

description of formations encountered from to

Shawville, Miss (mailing address)

Clay 0 32
Sand 32 83

WELL LOCATION:
sec 26 T 17 N R 8 E
6 miles south of Carrollville
(distance) (direction) (nearest town)

Clay 83 126
Sand 126 162

WELL PURPOSE: none
(home, irrigation, municipal, industrial)

Sand Clay streaks 162 223

WELL COMPLETION DATA:

Clay 223 230

- (1) diameter (inches) 2"
- (2) total depth (feet) 451
- (3) static water level (feet) 28 below top of ground.
- (4) casing PVC (material), (depth)

Sand 230 285

Sandy shale w/ sand streak 285 415

Sand (TECO) 415 468

(size) If telescope see back.

- (5) screen 10 (length), (depth to top)
2" (size), STAINLESS (material)

- (6) pump 1 (HP), 12 (yield gpm)
ele (type power)

- (7) electric log no (yes or no)

(organization running log)

- (8) how well bottom plugged


APR - 3 1970

MISS. BD. OF
WATER COMM.

DRILLERS REMARKS:

If well telescopes please sketch and show depths.

GROUND LEVEL

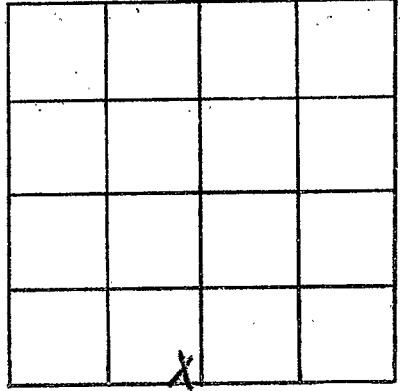

SECTION 26

Please indicate well location X.

ADDITIONAL INFORMATION

If more than one screen,
show locations of each on sketch.