

Washington
G-110
4-22-70

MISSISSIPPI
BOARD OF WATER COMMISSIONERS
416 North State Street
Jackson, Mississippi 39201

US 2
TE C&P

WATER WELL DRILLERS LOG

DYER WELL & IRRIGATION SERVICE

Washington

4-22-70
date well completed

firm name

county well located

LANDOWNER:	description of formations encountered	from	to
L + W Fish FARM	CLAY	0	23
Greenville, Miss. (mailing address)	SAND	23	64
	SAND + GRAVEL	64	103
WELL LOCATION:	CLAY	103	174
sec. 32 T-17 N R-8 E S W	ROCK	174	176
2 miles NE of Wayside (distance) (direction) (nearest town)	CLAY	176	198
WELL PURPOSE: Ind. (home, irrigation, municipal, industrial)	ROCK	198	199
WELL COMPLETION DATA:	CLAY	199	257
(1) diameter (inches) 4 X 3	SAND	257	261
(2) total depth (feet) 472	SAND + SLATE	261	358
(3) static water level (feet): _____ below top of ground.	SAND	358	382
(4) casing Steel, 442" (material) (depth)	SAND + CLAY	382	422
4 X 3 if telescope see back. (size)	HARD PACKED SAND	422	490
(5) screen 30, 442" (length) (depth to top)			
3" STAINLESS STEEL (size) (material)			
(6) pump 5, 80 (HP) (yield gpm)			
Elec. (type power)			
(7) electric log NO (yes or no)			
(organization running log)			
(8) how well bottom plugged BACK PRESSURE VALVE			
DRILLERS REMARKS:			

MAY 4 1970
MPT

MISS. BD. OF
WATER COMM.


If well telescopes please sketch and show depths.

GROUND LEVEL

168' - 4" CASING →

274' - 3" CASING →

30' - 3" SCREEN →

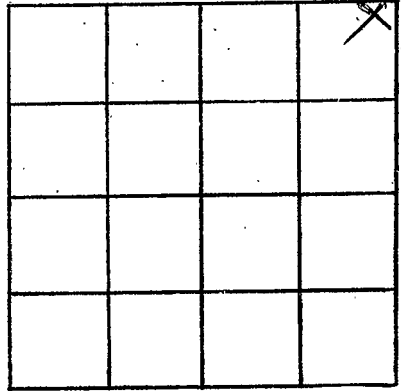

SECTION 32

Please indicate well location X.

ADDITIONAL INFORMATION

Series of horizontal lines for recording additional information.

If more than one screen, show locations of each on sketch.