

Washington
G 111
5-7-70

MISSISSIPPI
BOARD OF WATER COMMISSIONERS
416 North State Street
Jackson, Mississippi 39201

TE Cφ
US 2

WATER WELL DRILLERS LOG

5-7 1970 Bailey Drlg. Co. Washington
date well completed firm name county well located

LANDOWNER: Hoyt Nations
Greenville, Miss.
(mailing address)

description of formations encountered	from	to
Clay	0	30
Sand	30	85
Gravel	85	110
Mud	110	410
Fine sand + mud	410	450
Mud	450	490
Sand	490	530

WELL LOCATION:
sec. 15 T 17 R 9 020
4 miles S of Greenville
(distance) (direction) (nearest town)

WELL PURPOSE: Home
(home, irrigation, municipal, industrial)

- WELL COMPLETION DATA:
- (1) diameter (inches) 4 X 2
 - (2) total depth (feet) 530
 - (3) static water level (feet) 42 below above top of ground.
 - (4) casing steel
(material) (depth)
4 X 2 if telescope see back.
(size)
 - (5) screen 20', 570
(length) (depth to top)
2", Stainless Steel
(size) (material)
 - (6) pump 1 20
(HP) (yield gpm)
Elec
(type power)
 - (7) electric log no
(yes or no)

(organization running log)


(8) how well bottom plugged Back pressure valve

MAY 11 1970

DRILLERS REMARKS:

If well telescopes please sketch and show depths.

GROUND LEVEL

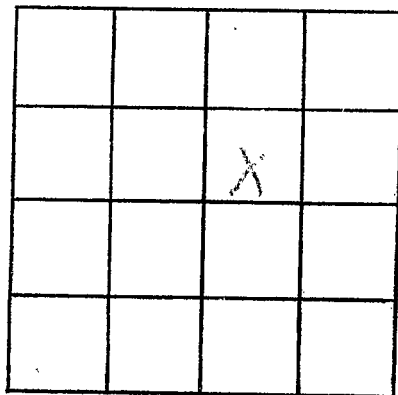

SECTION 15

Please indicate well location X.

ADDITIONAL INFORMATION

107' 11"

36.5' 2"

26' 11"

If more than one screen, show locations of each on sketch.