

WASHINGTON  
G112  
5-28-70

MISSISSIPPI  
BOARD OF WATER COMMISSIONERS  
416 North State Street  
Jackson, Mississippi 39201

Money for map sent Aug 10-70 mailed same day for

ADDED

WATER WELL DRILLERS LOG

Rn 7/13/70 led sent 10-70

5-2870  
date well completed

Argo Drilling Co  
firm name

Washington  
county well located

LANDOWNER:  
R. E. Dyers.  
Shremml Miss  
(mailing address)

description of formations encountered	from	to
Clay	0	14
white clay	14	21
blue clay	21	39
7" + medium Sand	39	49
7" + fine & coarse Sand	49	67

WELL LOCATION:  
sec 26 T 17 N R 8 E 7  
S W  
10 miles South of Shremml  
(distance) (direction) (nearest town)

WELL PURPOSE: Fish Farm  
(home, irrigation, municipal, industrial)

- WELL COMPLETION DATA:
- (1) diameter (inches) 10
  - (2) total depth (feet) 74
  - (3) static water level (feet) 12' below top of ground.
  - (4) casing ~~4"~~ 54' 3" (material) (depth)  
10" 1/4 medium Sand Pipe (size) if telescope see back.
  - (5) screen 20' 54' 3" (length) (depth to top)  
10" Black iron (size) (material)
  - (6) pump 20 900 GPM (HP) (yield gpm)  
Electric motor (type power)
  - (7) electric log No. (yes or no)

ADDED

(organization running log)  
(8) how well bottom plugged  
1/2 Steel Plate


JUN 11 1970

DRILLERS REMARKS:

MISS. Bd. OF WATER COMMISSIONERS

If well telescopes please sketch and show depths.

GROUND LEVEL

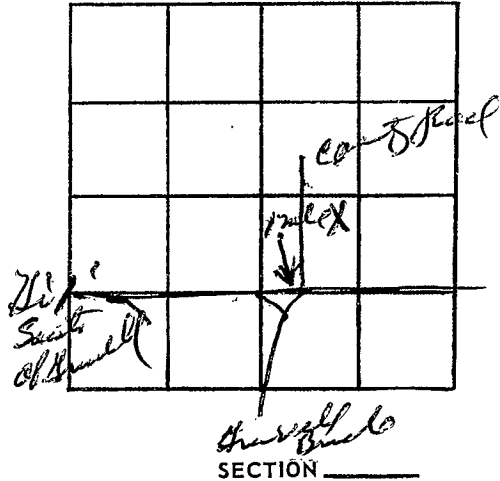

Please indicate well location X.

ADDITIONAL INFORMATION

This well located  
one mile East  
of this 10 miles South  
of Grenada.

If more than one screen,  
show locations of each on sketch.