

Washington  
G-115  
5-28-70

MISSISSIPPI  
BOARD OF WATER COMMISSIONERS  
416 North State Street  
Jackson, Mississippi 39201

**CODED**

WATER WELL DRILLERS LOG

May 28 1970 Schultz Drilling Washington  
date well completed firm name county well located

LANDOWNER: <u>R.C. Dyess</u> <u>Rt. 2.</u>	description of formations encountered	from	to
<u>Greenhill Man</u> (mailing address)	<u>Clay + Sand streak</u>	<u>0</u>	<u>28</u>
WELL LOCATION: sec <u>26</u> T <u>17</u> N R <u>8</u> W <u>3</u> miles <u>North</u> of <u>Wasside</u> (distance) (direction) (nearest town)	<u>Fine sand</u>	<u>28</u>	<u>46</u>
WELL PURPOSE: <u>dr</u> (home, irrigation, municipal, industrial)	<u>Fine to med sand</u>	<u>46</u>	<u>67</u>
WELL COMPLETION DATA: (1) diameter (inches) <u>10"</u>			
(2) total depth (feet) <u>67</u>			
(3) static water level (feet) <u>14</u> below top of ground.			
(4) casing <u>Steel</u> , <u>47</u> (material) (depth)			
<u>no</u> if telescope see back. (size)			
(5) screen <u>20</u> (length), <u>67</u> (depth to top)			
<u>10"</u> (size), <u>Steel</u> (material)			
(6) pump <u>20</u> (HP), <u>1,000</u> (yield gpm)			
<u>2 hp</u> (type power)			
(7) electric log <u>no</u> (yes or no)			
(8) how well bottom plugged <u>Steel pipe welded</u>			
DRILLERS REMARKS:			

**CODED**

JUN 12 1970


MISS. BD. OF  
WATER COMM.

JUN 2 1970

MISSISSIPPI  
WATER COMMISSIONERS

If well telescopes please sketch and show depths.

GROUND LEVEL

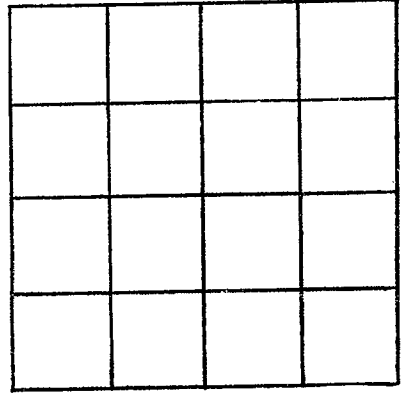

SECTION \_\_\_\_\_

Please indicate well location X.

ADDITIONAL INFORMATION

If more than one screen, show locations of each on sketch.