

~~WASHINGTON~~
 G 117
 10-20-70

MISSISSIPPI
 BOARD OF WATER COMMISSIONERS
 416 North State Street
 Jackson, Mississippi 39201

CODED

WATER WELL DRILLERS LOG

10-20 date well completed 19 70 OWENS plumbing firm name WASH county well located

LANDOWNER: F. Eddie P. Mitchell
Rt 2 Box 295.
GREENVILLE (mailing address) MISS.

WELL LOCATION:
 sec. 18 T. 17 N. R. 9 E.
6 miles W of GREENVILLE
 (distance) (direction) (nearest town)

WELL PURPOSE:
 (home) irrigation, municipal, industrial

WELL COMPLETION DATA:

- (1) diameter (inches) 2"
- (2) total depth (feet) 420
- (3) static water level (feet) 5.5 below/above top of ground.
- (4) casing GALV. 420
 (material) (depth)
 (size) if telescope see back.
- (5) screen 10 410
 (length) (depth to top)
2" GALV.
 (size) (material)
- (6) pump 1 10
 (HP) (yield gpm)
ELEC.
 (type power)
- (7) electric log NO
 (yes or no)
- (organization running log)
- (8) how well bottom plugged 3/4 P.

description of formations encountered	from	to
SAND MIXED	1	15
SAND	15	60
SAND AND GRAVEL	60	100
BLUE CLAY	100	160
SAND & CLAY	160	190
ROCK	190	290
SAND CLAY SHIPS	290	330
SAND	330	420

CODED


OCT 28 1970

MISS. BD. OF
 WATER COMMISSIONERS

DRILLERS REMARKS: OWENS

If well telescopes please sketch and show depths.

GROUND LEVEL

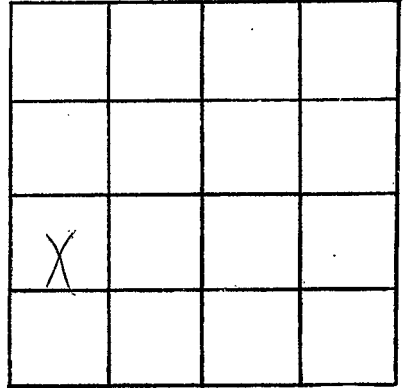

SECTION _____

Please indicate well location X.

ADDITIONAL INFORMATION

If more than one screen, show locations of each on sketch.