

WASHINGTON
G 118
10-5-70

MISSISSIPPI
BOARD OF WATER COMMISSIONERS
416 North State Street
Jackson, Mississippi 39201

CODED

WATER WELL DRILLERS LOG

10/5 1970 date well completed
Bailey Drilling Co. firm name
Washington county well located

LANDOWNER: J. H. Burt
Wayside, Miss
(mailing address)

WELL LOCATION:
sec. 4 T 17 N R 8 E S W
1/2 miles N of Wayside
(distance) (direction) (nearest town)

WELL PURPOSE: Home
(home, irrigation, municipal, industrial)

WELL COMPLETION DATA:

- (1) diameter (inches) 4 X 2
- (2) total depth (feet) 260
- (3) static water level (feet) 20' below top of ground.
- (4) casing Steel (material), (depth)
- 4 X 2 (size) if telescope see back.
- (5) screen 15' (length), 445' (depth to top)
2" (size), Stainless Steel (material)
- (6) pump 1 (HP), 20 (yield gpm)
Elec (type power)
- (7) electric log No. (yes or no)
- (organization running log)
- (8) how well bottom plugged Back pressure valve

description of formations encountered	from	to
Clay	0	30
Sand	30	80
Gravel	80	95
Mud	95	120
Sand + Mud	120	134
Rock	134	135
Mud & Sand	135	159
Rock	159	160
Mud	160	182
Sand	182	230
Hard place	230	231
Sand	231	260

CODED


NOV 5 - 1970

DRILLERS REMARKS:

If well telescopes please sketch and show depths.

GROUND LEVEL

210' 11"
25' 00"
15' 00" 11" 2

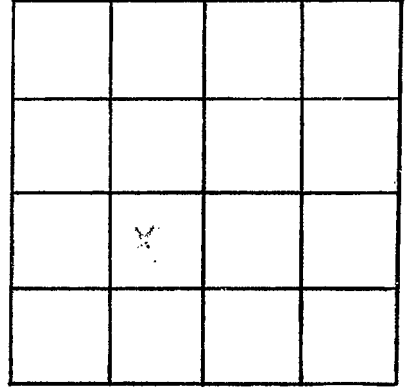

SECTION 11

Please indicate well location X.

ADDITIONAL INFORMATION

If more than one screen,
show locations of each on sketch.