

WASHINGTON  
G 122  
6-26-71

MISSISSIPPI  
BOARD OF WATER COMMISSIONERS  
416 North State Street  
Jackson, Mississippi 39201

**CODED**

WATER WELL DRILLERS LOG

6/26 1971 Schutte Drilling Co Washington  
date well completed firm name county well logged

LANDOWNER: M P & L  
T. L. James Constructs  
Kenner, La  
(mailing address)

| description of formations encountered | from | to  |
|---------------------------------------|------|-----|
| clay                                  | 0    | 18  |
| sand                                  | 18   | 200 |

WELL LOCATION:  
sec. 1 T. 17 N R. 9 E  
5 miles SW of GVI  
(distance) (direction) (nearest town)

WELL PURPOSE: Home  
(home, irrigation, municipal, industrial)

- WELL COMPLETION DATA:
- (1) diameter (inches) 2"
  - (2) total depth (feet) 25
  - (3) static water level (feet) 24 below top of ground.
  - (4) casing Plastic (material) (depth) (size) if telescope see back.
  - (5) screen 5 (length) (depth to top) 20 Plastic (size) (material)
  - (6) pump 10 (HP) 10 (yield gpm) Elec (type power)
  - (7) electric log no (yes or no)  
(organization running log)
  - (8) how well bottom plugged Plug

This well will be pulled in 12 months. Construction otherwise only.


**CODED**

JUL 9 1971

DRILLERS REMARKS:

If well telescopes please sketch and show depths.

GROUND LEVEL

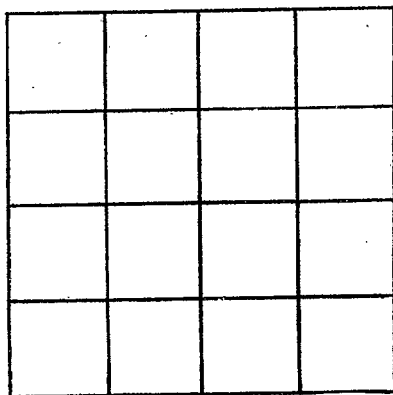

SECTION \_\_\_\_\_

Please indicate well location X.

ADDITIONAL INFORMATION

If more than one screen, show locations of each on sketch.