

WASHINGTON
 G123
 7-7-71

MISSISSIPPI
 BOARD OF WATER COMMISSIONERS
 416 North State Street
 Jackson, Mississippi 39201

CODED

WATER WELL DRILLERS LOG

C3516R

July 7, 1971 SINGER-Layne Central Division Washington
 date well completed firm name county well located

LANDOWNER:	description of formations encountered	from	to
Bectel Corporation	Sandy clay	0	5
Greenville, Mississippi	Fine sand	50	25
for Miss. Power & Light Co.	Sand, medium	25	44
(mailing address)	Coarse sand	44	65
WELL LOCATION:	Coarse sand, some pea gravel	65	82
sec. <u>1</u> T. <u>17</u> N. R. <u>9</u> W			
_____ miles of Greenville			
(distance) (direction) of (nearest town)			
WELL PURPOSE: industrial			
(home, irrigation, municipal, industrial)			
WELL COMPLETION DATA:			
(1) diameter (inches) <u>12"</u>			
(2) total depth (feet) <u>85'5"</u>			
(3) static water level (feet) <u>13'</u> below above top of ground.			
(4) casing <u>steel</u> , <u>55'5"</u>			
(material) (depth)			
<u>12"</u> If telescope see back.			
(size)			
(5) screen <u>30'</u> , <u>85'5"</u>			
(length) (depth to top)			
<u>12"</u> , <u>Free Flow</u>			
(size) (material)			
(6) pump <u>50</u> , <u>700</u>			
(HP) (yield gpm)			
<u>engine</u>			
(type power)			
(7) electric log <u>no</u>			
(yes or no)			
(organization running log)			
(8) how well bottom plugged <u>plate</u>			
DRILLERS REMARKS:			


CODED

JUL 27 1971

MISS. BD. OF
 WATER COMM.

If well telescopes please
sketch and show depths.

GROUND LEVEL

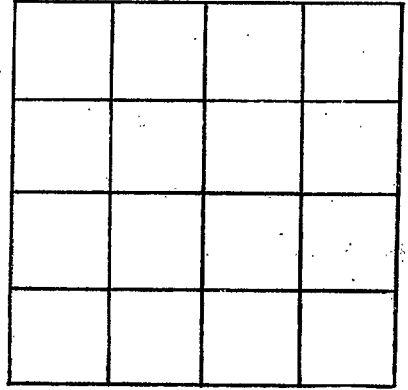

SECTION _____

Please indicate well location X.

ADDITIONAL INFORMATION

If more than one screen,
show locations of each on sketch.