

Wash.
G-125
8-12-71

MISSISSIPPI
BOARD OF WATER COMMISSIONERS
416 North State Street
Jackson, Mississippi 39201

CODED

WATER WELL DRILLERS LOG

12 Aug 1971 date well completed
Lambert Drilling Co. Wash firm name
county well located

LANDOWNER: Bob Taylor

Wilmont Rd.

Greenville, Miss.
(mailing address)

description of formations encountered

from to

Clay

0 85

Sand

85 90

Sand & gravel

60 89

Clay

89 120

Sand

120 135

Rock

135 186

Sand & clay st.

186 188

Rock

185 187

Sand & Clay st.

187 280

Rock

280 281

Sand & Clay st.

281 325

Sand

325 385

Sand good

385 435

WELL LOCATION:

sec 26 T 17 N R 8 E
8 miles S of Greenville
(distance) (direction) (nearest town)

WELL PURPOSE: none
(home, irrigation, municipal, industrial)

WELL COMPLETION DATA:

(1) diameter (inches) 2
(2) total depth (feet) 435
(3) static water level (feet) 28 below top of ground.

(4) casing galv. 425 (material) (depth)
if telescope see back.
(size)

(5) screen 10 435 (length) (depth to top)
2" 35 (size) (material)

(6) pump 1 950/hr. (HP) (yield gpm)
ELECT (type power)

(7) electric log (yes or no)

(organization running log)


(8) how well bottom plugged
back wash valve

DRILLERS REMARKS:

AUG 30 1971

If well telescopes please sketch and show depths.

GROUND LEVEL

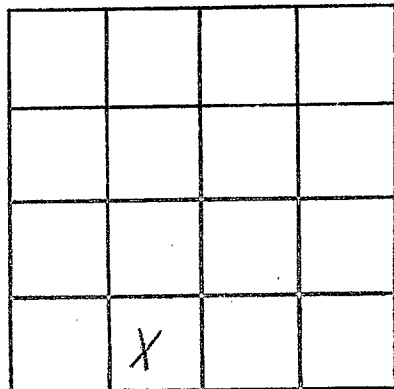

SECTION 26

Please indicate well location X.

ADDITIONAL INFORMATION

If more than one screen, show locations of each on sketch.