

CODED

EL06#72

WASHINGTON

G132

1-23-72

MISSISSIPPI
BOARD OF WATER COMMISSIONERS

416 North State Street

CI4317-3683

Jackson, Mississippi 39201

WATER WELL DRILLERS LOG

January 23, 1972 SINGER-Layne Central Division Washington

date well completed

firm name


county well located

LANDOWNER:	description of formations encountered	from	to
Bechtel Corporation	Sand fill	0	26
Greenville, Mississippi	Soft clay	26	32
(mailing address)	Medium sand	32	50
WELL LOCATION:	Co. sand, gravel	50	136
sec. 1 T17N R9W	Clay	136	145
of Greenville	Sand	145	270
(distance) miles (direction) of (nearest town)	Clay	270	293
WELL PURPOSE: industrial	Sandy shale	293	416
(home, irrigation, municipal, industrial)	Fine sand	416	497
WELL COMPLETION DATA:			
(1) diameter (inches) 10 x 6			
(2) total depth (feet) 473'			
(3) static water level (feet) 67' below top of ground.			
(4) casing steel 406' (material), (depth)			
10" (size) if telescope see back.			
5' BPV			
(5) screen 60' 4" (length), 468' (depth to top)			
6" stainless steel (size), (material)			
(6) pump 40 (HP), 500 (yield gpm)			
electric (type power)			
(7) electric log XXXXXX yes (yes or no)			
U.S.G.S. (organization running log)			
(8) how well bottom plugged BPV			
DRILLERS REMARKS:			

CODED

If well telescopes please sketch and show depths.

GROUND LEVEL

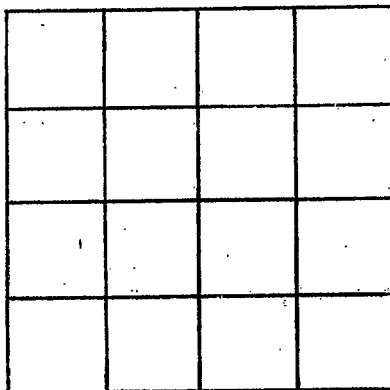

SECTION _____

Please indicate well location X.

ADDITIONAL INFORMATION

If more than one screen,
show locations of each on sketch.