

WASHINGTON
G135
1-5-72

MISSISSIPPI
BOARD OF WATER COMMISSIONERS
416 North State Street
Jackson, Mississippi 39201

CODED
FEB 14 1972

WATER WELL DRILLERS LOG

1-5
date well completed

1972 Schultz Drilling
firm name

Washington
county well located

LANDOWNER: Loewell Jones

description of formations
encountered

from to

Greenville, Miss
(mailing address)

Clay
Sand

0 22
72 70

WELL LOCATION:

sec 24 T 17 N R 8 W
5 miles S of GREENVILLE
(distance) (direction) (nearest town)

WELL PURPOSE: None
(home, irrigation, municipal, industrial)

WELL COMPLETION DATA:

(1) diameter (inches) 2"
(2) total depth (feet) 164
(3) static water level (feet) 15 below
top of ground above

(4) casing Plastic
(material) (depth)
(size) if telescope see back.

(5) screen 4
(length) (depth to top)
2" Plastic
(size) (material)

(6) pump 1/2 15
(HP) (yield gpm)
(type power)

(7) electric log (yes or no)

(organization running log)


(8) how well bottom plugged Plugged

DRILLERS REMARKS:

CODED

If well telescopes please sketch and show depths.

GROUND LEVEL

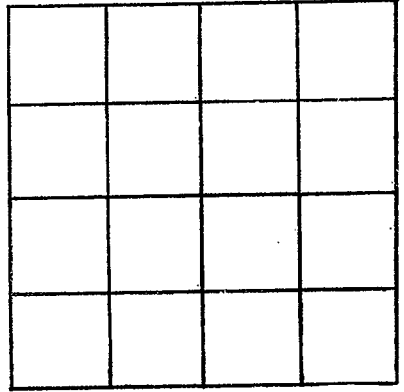

SECTION _____

Please indicate well location X.

ADDITIONAL INFORMATION

If more than one screen,
show locations of each on sketch.