

Washington  
G136  
1-6-72

MISSISSIPPI  
BOARD OF WATER COMMISSIONERS  
416 North State Street  
Jackson, Mississippi 39201

FEB 14 1972

WATER WELL DRILLERS LOG

MISS. REG.

Washington

1-6 date well completed 1972 Seburtz Drilling firm name Washington county well located

LANDOWNER: Lucy May Wells  
Pt. 2  
Greenville, Miss  
(mailing address)

description of formations encountered	from to	
Clay	0	28
SAND	28	70

CODED

WELL LOCATION:  
sec. 24 T. 17 N R. 8 E  
5 miles S of Greenville  
(distance) (direction) (nearest town)

WELL PURPOSE: Home  
(home, irrigation, municipal, industrial)


- WELL COMPLETION DATA:
- (1) diameter (inches) 2"
  - (2) total depth (feet) 64
  - (3) static water level (feet) 15 below top of ground
  - (4) casing (material) Plastic (depth) (size) If telescope see back.
  - (5) screen 4 (length) (depth to top) 2" (size) Plastic (material)
  - (6) pump (HP) (yield gpm) (type power)
  - (7) electric log (yes or no) (organization running log)
  - (8) how well bottom plugged

CODED

DRILLERS REMARKS:

If well telescopes please sketch and show depths.

GROUND LEVEL

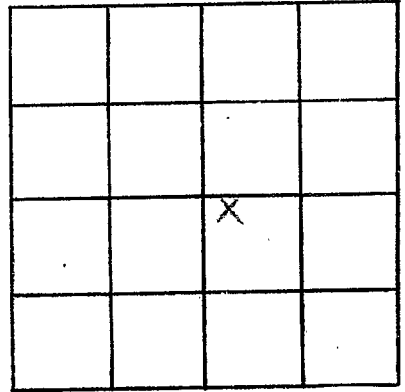

SECTION 24

Please indicate well location X.

ADDITIONAL INFORMATION

If more than one screen, show locations of each on sketch.