

Washington
 G137
 2-10-72

MISSISSIPPI
 BOARD OF WATER COMMISSIONERS

416 North State Street
 Jackson, Mississippi 39201

FEB 14 1972

WATER WELL DRILLERS LOG

MISS. BD/ OR

2-10
 date well completed

1972 Schultz Drilling Co
 firm name

Washington
 county well located

LANDOWNER:

Amco Chemical

description of formations encountered

from to

Wayside, Miss
 (mailing address)

clay
 sand

0 7
 7 50

WELL LOCATION:

sec 2 T 17 R 8
 1 miles 3 of Wayside
 (distance) (direction) (nearest town)

CODED

WELL PURPOSE:

(home, irrigation, municipal, industrial)

WELL COMPLETION DATA:


- (1) diameter (inches) 2"
- (2) total depth (feet) 44
- (3) static water level (feet) 14 below above top of ground.
- (4) casing Plastic (material), (depth), (size) if telescope see back.
- (5) screen 4 (length), (depth to top) 5" Plastic (size) (material)
- (6) pump (HP) (yield gpm) (type power)
- (7) electric log (yes or no) (organization running log)
- (8) how well bottom plugged

CODED

DRILLERS REMARKS:

If well telescopes please sketch and show depths.

GROUND LEVEL

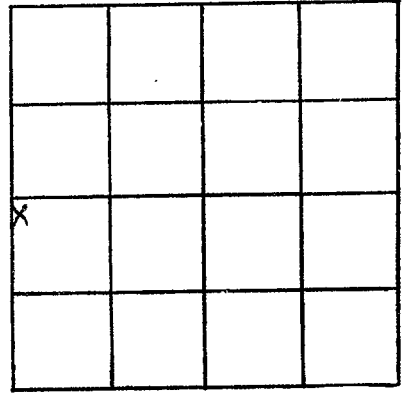

SECTION 2

Please indicate well location X.

ADDITIONAL INFORMATION

If more than one screen,
show locations of each on sketch.