

WASHINGTON  
G141  
5-4-72

MISSISSIPPI  
BOARD OF WATER COMMISSIONERS  
416 North State Street  
Jackson, Mississippi 39201

CODED 39-8813

WATER WELL DRILLERS LOG

May 4, 1972 Singer-Layne Central Division Washington  
date well completed firm name county well located

LANDOWNER: <u>Aqua Farms, Inc.</u> <u>Arcola, Mississippi</u>  (mailing address)	description of formations encountered	from	to
	Clay	0	38
	Sand, med. coarse	38	45
	Coarse sand	45	65
	Coarse sand & pea gravel	65	70
	Coarse sand & gravel	70	74
	Clay bottom	74	75
WELL LOCATION: sec. <u>31</u> T <u>17</u> N R. <u>8</u> E W <u>5</u> miles NW of <u>Arcola</u> (distance) (direction) (nearest town)			
WELL PURPOSE: <u>irrigation</u> (home, irrigation, municipal, industrial)			
WELL COMPLETION DATA:			
(1) diameter (inches) <u>16</u>			
(2) total depth (feet) <u>44</u>			
(3) static water level (feet) <u>26'</u> below top of ground. <del>above</del>			
(4) casing <u>Steel</u> <u>44'</u> (material) (depth) <u>16"</u> if telescope see back. (size)			
(5) screen <u>30'</u> <u>74'</u> (length) (depth to top) <u>16"</u> <u>Armco</u> (size) (material)			
(6) pump <u>30</u> <u>1200</u> (HP) (yield gpm) <u>electric</u> (type power)			
(7) electric log <u>no</u> (yes or no)  (organization running log)			
(8) how well bottom plugged <u>plate</u>			
DRILLERS REMARKS:			


CODED

MAY 15 1972

MISS. BD. C.  
WATER DIV.

If well telescopes please sketch and show depths.

GROUND LEVEL

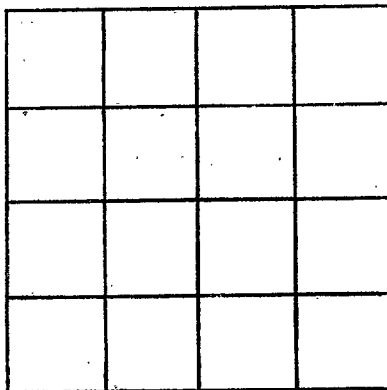

SECTION \_\_\_\_\_

Please indicate well location X.

ADDITIONAL INFORMATION

If more than one screen, show locations of each on sketch.