

WASHINGTON
G144
8-20-72

MISSISSIPPI
BOARD OF WATER COMMISSIONERS
416 North State Street
Jackson, Mississippi 39201

CODED

WATER WELL DRILLERS LOG

8/20 / date well completed
1970 *W. Schultz Drilling* firm name
Washington county well located

LANDOWNER:
J. C. Davis
Rt. 2 Greenville Miss
(mailing address)

description of formations encountered	from	to
<i>Clay</i>	<i>19</i>	<i>29</i>
<i>Sand</i>	<i>29</i>	<i>65</i>

WELL LOCATION:
sec. *25* T. *17* N. R. *8 E*
5 miles *South* of *Bull*
(distance) (direction) (nearest town)

WELL PURPOSE: *Home*
(home, irrigation, municipal, industrial)

- WELL COMPLETION DATA:
- (1) diameter (inches) *2"*
 - (2) total depth (feet) *65*
 - (3) static water level (feet) *17* below top of ground
 - (4) casing *Plastic*
(material) (depth)
 - (size) if telescope see back.
 - (5) screen *5 ft*
(length) (depth to top)
 - 2"*
(size) (material)
 - (6) pump _____ (HP) (yield gpm)
 - (type power)
 - (7) electric log _____ (yes or no)
 - (organization running log)
 - (8) how well bottom plugged *Cap*

CODED


OCT 12 1972

MISSISSIPPI BOARD OF WATER COMMISSIONERS

DRILLERS REMARKS:

If well telescopes please sketch and show depths.

GROUND LEVEL

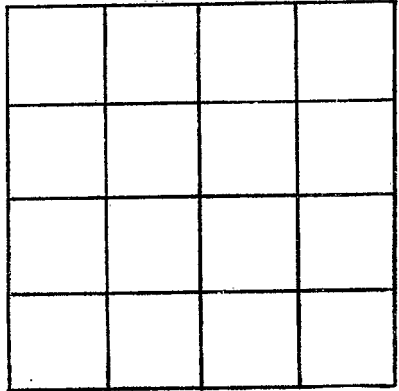

SECTION _____

Please indicate well location X.

ADDITIONAL INFORMATION

If more than one screen,
show locations of each on sketch.