

WASHINGTON  
G145  
8-21-72

MISSISSIPPI  
BOARD OF WATER COMMISSIONERS  
416 North State Street  
Jackson, Mississippi 39201

**CODED**

WATER WELL DRILLERS LOG

8-21 1972 South Drilling Washington  
date well completed firm name county well located


LANDOWNER: <u>Emerson Brown</u>	description of formations encountered	from	to
<u>Chicago Drilling</u> (mailing address)			
	<u>sand</u>	<u>38</u>	<u>65</u>
<b>WELL LOCATION:</b>			
sec. <u>25</u> T <u>17</u> N R <u>8</u> E W			
(distance) miles (direction) of (nearest town)			
<b>WELL PURPOSE:</b> <u>Home</u> (home, irrigation, municipal, industrial)			
<b>WELL COMPLETION DATA:</b>			
(1) diameter (inches) <u>2"</u>			
(2) total depth (feet) <u>65</u>			
(3) static water level (feet) <u>16</u> below top of ground.			
(4) casing <u>PVC</u> (material) <u>60</u> (depth)			
(size) _____ if telescope see back.			
(5) screen <u>5ft</u> (length) _____ (depth to top)			
<u>2"</u> (size) <u>PVC</u> (material)			
(6) pump <u>None</u> (HP) _____ (yield gpm)			
(type power) _____			
(7) electric log _____ (yes or no)			
(organization running log) _____			
(8) how well bottom plugged <u>Clay</u>			
<b>DRILLERS REMARKS:</b>			

**CODED**

FEB 5 1973

If well telescopes please sketch and show depths.

GROUND LEVEL

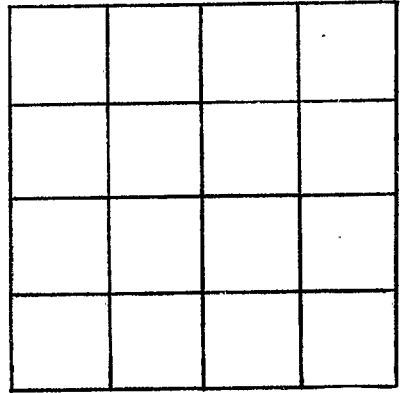

SECTION \_\_\_\_\_

Please indicate well location X.

ADDITIONAL INFORMATION

If more than one screen,  
show locations of each on sketch.