

WASHINGTON

G146

12-7-73

MISSISSIPPI BOARD OF WATER COMMISSIONERS  
416 North State Street  
Jackson, Mississippi 39201

**CODED**

WATER WELL DRILLERS LOG

12/5

1973

Schultz Drilling

Washington

date well completed

firm name

county well located

LANDOWNER: Robert Taylor

description of formations encountered

from

to

Greenville, Miss  
(mailing address)

Clay  
Sand

0 26  
26 93

WELL LOCATION:

sec. 12 T 17 N R 8 E  
5 miles 3 of E.V.I.  
(distance) (direction) (nearest town)

Clay  
Sand

93 215  
215 221

WELL PURPOSE:

Home  
(home, irrigation, municipal, industrial)

Clay  
Sand

221 282  
~~282~~  
282 455

WELL COMPLETION DATA:

- (1) diameter (inches) 4" X 2"
- (2) total depth (feet) 430
- (3) static water level (feet) 39 below top of ground.
- (4) casing P.V.C. 430  
(material) (depth)  
If telescope see back.  
(size)
- (5) screen 30  
(length) (depth to top)  
2" P.V.C.  
(size) (material)
- (6) pump 1/2 HP 30  
(HP) (yield gpm)  
Electric  
(type power)
- (7) electric log no  
(yes or no)

**CODED**

(organization running log)

(8) how well bottom plugged


DRILLERS REMARKS:

FFR 5 1973

MISSISSIPPI BOARD OF WATER COMMISSIONERS

If well telescopes please sketch and show depths.

GROUND LEVEL

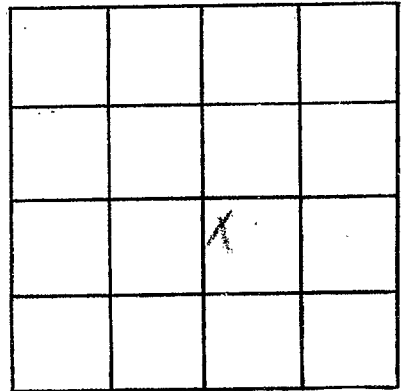

SECTION 13

Please indicate well location X.

ADDITIONAL INFORMATION

If more than one screen, show locations of each on sketch.