

G 149
 WASHINGTON
 8-21-73

MISSISSIPPI **CODED**
 BOARD OF WATER COMMISSIONERS
 416 North State Street
 Jackson, Mississippi 39201

WATER WELL DRILLERS LOG

8/21 1973 *Suburban Drilling* *Washington*
 date well completed firm name county well located


LANDOWNER: <i>George Brown</i>	description of formations encountered	from	to
<i>Pl. 2</i>			
<i>Greenville, Miss</i> (mailing address)	<i>Clay</i>	<i>0</i>	<i>33</i>
	<i>Sand</i>	<i>33</i>	<i>90</i>
WELL LOCATION: sec. <i>27</i> T. <i>17</i> N. R. <i>8</i> E <i>5</i> miles <i>5</i> of <i>Wind</i> (distance) (direction) (nearest town)	<i>Clay</i>	<i>90</i>	<i>128</i>
	<i>Sandy shale</i>	<i>128</i>	<i>145</i>
WELL PURPOSE: (home, irrigation, municipal, industrial)	<i>Sand</i>	<i>145</i>	<i>230</i>
WELL COMPLETION DATA:	<i>Plg break</i>	<i>130</i>	<i>236</i>
(1) diameter (inches) <i>2"</i>	<i>Sand</i>	<i>236</i>	<i>300</i>
(2) total depth (feet) <i>290</i>			
(3) static water level (feet) <i>27</i> below top of ground.			
(4) casing <i>PVC</i> (material) (depth) _____ (size) if telescope see back.			
(5) screen <i>10</i> (length) (depth to top) _____ <i>2"</i> (size) <i>PVC</i> (material)			
(6) pump <i>1</i> (HP) <i>10</i> (yield gpm) <i>3/4</i> (type power)			
(7) electric log <i>no</i> (yes or no) (organization running log) _____			
(8) how well bottom plugged <i>Spiral</i>			
DRILLERS REMARKS:			

CODED

AUG 28 1973

If well telescopes please sketch and show depths.

GROUND LEVEL

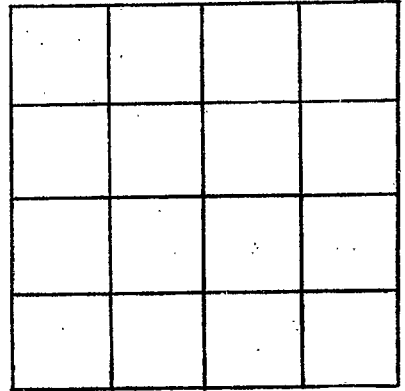

SECTION _____

Please indicate well location X.

ADDITIONAL INFORMATION

If more than one screen,
show locations of each on sketch.