

**WASHINGTON**  
**G 155**  
**1-11-74**

MISSISSIPPI  
 BOARD OF WATER COMMISSIONERS  
 416 North State Street  
 Jackson, Mississippi 39201

**WATER WELL DRILLERS LOG**


1-11 date well completed    1974 Schultz Drilling firm name    Washington county well located

LANDOWNER:	description of formations encountered	from	to
<u>Frank Byrum</u>			
<u>Pt. R.</u>	<u>Sand</u>	<u>31</u>	<u>90</u>
<u>Bergenville, Miss.</u> (mailing address)	<u>Clay</u>	<u>190</u>	<u>126</u>
<b>WELL LOCATION:</b>	<u>Sandy Shale</u>	<u>126</u>	<u>147</u>
sec. <u>27</u> T. <u>17</u> N. R. <u>8</u> E	<u>Sand</u>	<u>147</u>	<u>216</u>
<u>5</u> miles <u>S</u> of <u>Gul</u>	<u>Clay</u>	<u>216</u>	<u>230</u>
(distance) (direction) of (nearest town)	<u>Sand</u>	<u>230</u>	<u>300</u>
<b>WELL PURPOSE:</b>			
(home, irrigation, municipal, industrial)			
<b>WELL COMPLETION DATA:</b>			
(1) diameter (inches) <u>2"</u>			
(2) total depth (feet) <u>290</u>			
(3) static water level (feet) <u>27</u> below top of ground.			
(4) casing <u>PVC</u> (material), (depth), (size) if telescope see back.			
(5) screen <u>10</u> (length), (depth to top) <u>2</u> (size), <u>PVC</u> (material)			
(6) pump <u>1</u> (HP), <u>10</u> (yield gpm), <u>etc</u> (type power)			
(7) electric log <u>no</u> (yes or no)			
(organization running log)			
(8) how well bottom plugged <u>Sealed</u>			
<b>DRILLERS REMARKS:</b>			

MISSISSIPPI BOARD OF WATER COMMISSIONERS  
 JACKSON, MISSISSIPPI 39201

If well telescopes please sketch and show depths.

GROUND LEVEL

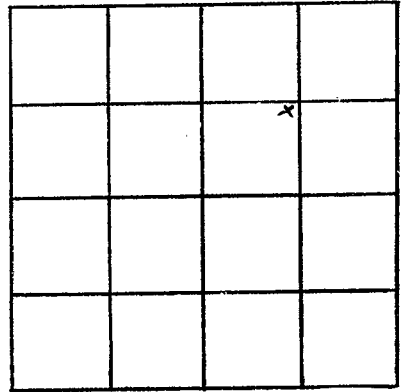

SECTION 2

Please indicate well location X.

ADDITIONAL INFORMATION

If more than one screen,  
show locations of each on sketch.