

WASHINGTON

MISSISSIPPI BOARD OF WATER COMMISSIONERS
416 North State Street
Jackson, Mississippi 39201

6 156
A-2A-74

WATER WELL DRILLERS LOG **CODED**

April 24 1974 Dwens P/bg Wzsh.
date well completed firm name county well located

LANDOWNER: Hannie Bell Jones
Wolmont Rd.
Greenville, MS. 38707
(mailing address)

Description of formations encountered	from	to
top soil	0	21
Clay	21	121
Sand	121	170
Sand + Gravel	170	270
Rock + sand	270	282
Sand	282	452

WELL LOCATION:
see 24 T 17 N R 8 E
18 miles South of Greenville
(distance) (direction) (nearest town)

WELL PURPOSE: Home
(home, irrigation, municipal, industrial)

CODED


- WELL COMPLETION DATA:
- (1) diameter (inches) 2"
 - (2) total depth (feet) 452 Ft.
 - (3) static water level (feet) 20 below top of ground.
 - (4) casing 2" 442'
(material) (depth)
 - (size) If telescope see back.
 - (5) screen 10 Ft. 452 Ft.
(length) (depth to top)
 - 2" S.S.
(size) (material)
 - (6) pump 1 27
(HP) (yield gpm)
 - elec.
(type power)
 - (7) electric log no
(yes or no)
 - (organization running log)
 - (8) how well bottom plugged S.B.

RECORDED
MAY
MISS. BD. OF WATER COMM.

DRILLERS REMARKS: Dwens

If well telescopes please sketch and show depths.

GROUND LEVEL

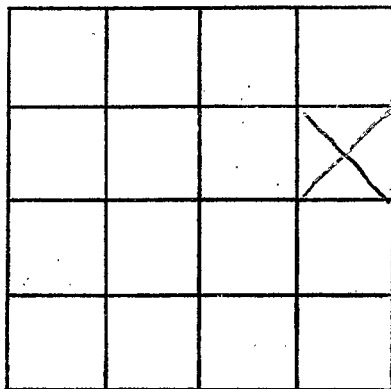

SECTION _____

Please indicate well location X.

ADDITIONAL INFORMATION

If more than one screen, show locations of each on sketch.