

CODED

MISSISSIPPI BOARD OF WATER COMMISSIONERS  
416 North State Street  
Jackson, Mississippi 39201

WATER WELL DRILLERS LOG

WASH.  
G157  
S-28-74

5/28 1974 Bailey Drilling Co Washington  
date well completed firm name county well located

LANDOWNER: Wesley Pickle  
Greenville, Miss.  
(mailing address)

description of formations encountered	from	to
Clay	0	10
Sands	10	90
Gravel	90	115
Mud	115	145
Rock	145	145 1/2
Mud	145 1/2	305
Sand	305	397

WELL LOCATION:  
sec 2 T 17 R 9  
7 miles SW of Greenville  
(distance) (direction) (nearest town)

WELL PURPOSE: Industrial  
(home, irrigation, municipal, industrial)

WELL COMPLETION DATA:

- (1) diameter (inches) 4 X 2 1/2
- (2) total depth (feet) 397
- (3) static water level (feet) 35 below top of ground.
- (4) casing Steel, 372,  
(material) (depth)  
4 X 2 1/2 if telescope see back.  
(size)
- (5) screen 25, 372  
(length) (depth to top)  
2 1/2, Stainless Steel  
(size) (material)
- (6) pump 5 60  
(HP) (yield gpm)  
Electric  
(type power)
- (7) electric log No  
(yes or no)

(organization running log)


(8) how well bottom plugged  
Back pressure valve

DRILLERS REMARKS:

CODED

If well telescopes please sketch and show depths.

GROUND LEVEL

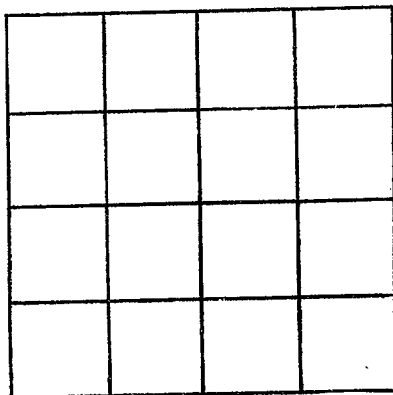

SECTION \_\_\_\_\_

Please indicate well location X.

ADDITIONAL INFORMATION

If more than one screen,  
show locations of each on sketch.