

WASHINGTON
G159
9-13-74

MISSISSIPPI
BOARD OF WATER COMMISSIONERS
416 North State Street
Jackson, Mississippi 39201

CODED

WATER WELL DRILLERS LOG

9/13/74 date well completed 1974 Bailey Drilling Co firm name Washington county well located

LANDOWNER: Wasic Foods
Greenville
Miss. 38701
(mailing address)

description of formations encountered	from	to
Clay	0	5
Sand	5	90
Gravel	90	121
Sand + Mud	121	220
Mud	220	250
Rock	250	250 1/2
Mud	250 1/2	357
Rock	357	357 1/2
Mud	357 1/2	380
Sand	380	394
Mud	394	400
Sand	400	465

WELL LOCATION:
sec. 2 T. 17 N. R. 9 E
6 miles SW of Greenville
(distance) (direction) (nearest town)

WELL PURPOSE: Industrial
(home, irrigation, municipal, industrial)

- WELL COMPLETION DATA:
- (1) diameter (inches) 8"
 - (2) total depth (feet) 465
 - (3) static water level (feet) 40' below top of ground.
 - (4) casing Steel, 415'
(material) (depth)
8" if telescope see back.
(size)
 - (5) screen 50', 415'
(length) (depth to top)
6", Stainless Steel
(size) (material)
 - (6) pump 40, 300
(HP) (yield gpm)
Electric
(type power)
 - (7) electric log No
(yes or no)

(organization running log)
(8) how well bottom plugged Rock
pressure valve

DRILLERS REMARKS:

REGISTERED
MAY 1974
SEP 19 1974


MISS. Bd. OF WATER COMMISSIONERS

If well telescopes please sketch and show depths.

GROUND LEVEL

415' 4 8"

50' 4 6 20000

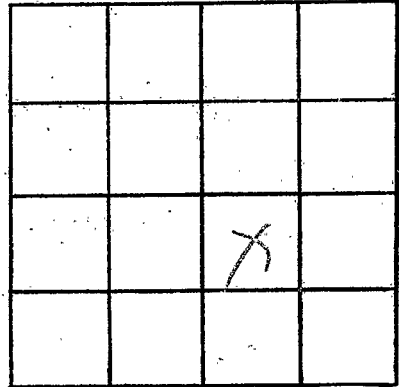

SECTION 2

Please indicate well location X.

ADDITIONAL INFORMATION

If more than one screen, show locations of each on sketch.