

WASH.
 G 163
 4-7-75

MISSISSIPPI
 BOARD OF WATER COMMISSIONERS
 416 North State Street
 Jackson, Mississippi 39201

CODED

WATER WELL DRILLERS LOG

Apr. 7 1975 Bailey Drilling Co. Washington
 date well completed firm name county well located

LANDOWNER: Classic Foods

Greenville

Miss.

(mailing address)

WELL LOCATION:

sec. 2 T. 17 N. R. 9 E

5 miles SW of Greenville
 (distance) (direction) (nearest town)

WELL PURPOSE: Industrial
 (home, irrigation, municipal, industrial)

WELL COMPLETION DATA:

- (1) diameter (inches) 8"
- (2) total depth (feet) 400
- (3) static water level (feet) 38 below top of ground.
- (4) casing steel, 350'
 (material) (depth)
8x6 If telescope see back.
 (size)
- (5) screen 40', 360
 (length) (depth to top)
6", Stainless steel
 (size) (material)
- (6) pump 40 3009NM
 (HP) (yield gpm)
Electric
 (type power)
- (7) electric log No
 (yes or no)

(organization running log)

(8) how well bottom plugged
Back pressure valve

DRILLERS REMARKS:

description of formations encountered

from to

Clay	0	10
Sand	10	90
Gravel	90	115
Mud	115	145
Rock	145	145 1/2
Mud	145 1/2	210
Rock	210	210 1/2
Mud	210 1/2	305
Sand	305	400

CODED

RECEIVED
 APR 7 1975

MISS. BD. OF WATER COMMISSIONERS


If well telescopes please sketch and show depths.

GROUND LEVEL

360' 8"

20' 6" lapped
into 8"

40' 6" screen

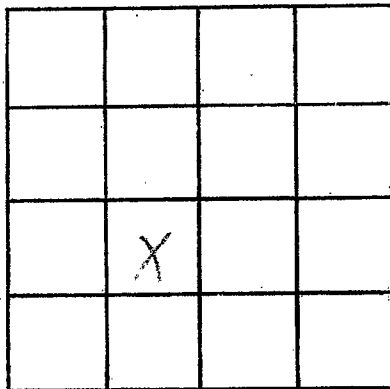

SECTION _____

Please indicate well location X.

ADDITIONAL INFORMATION

If more than one screen,
show locations of each on sketch.