

WASH
 543/170
 11/2/78

MISSISSIPPI
 BOARD OF WATER COMMISSIONERS
 416 North State Street
 Jackson, Mississippi 39201

WATER WELL DRILLERS LOG CODED

12 NOV 1978 Lambert Dr. Hwy Wash
 date well completed firm name county well located

LANDOWNER:
 Orchard Plt.
 Greenville, Miss.
 (mailing address)

WELL LOCATION:
 sec 14 T 17 N R 8 E
 5 miles S/W of Greenville
 (distance) (direction) (nearest town)

WELL PURPOSE: home
 (home, irrigation, municipal, industrial)

- WELL COMPLETION DATA:
- (1) diameter (inches) 4x2 1/2
 - (2) total depth (feet) 485
 - (3) static water level (feet) 52 below top of ground.
 - (4) casing PVC, 455 (material), (depth)
 4x2 1/2 (size) if telescope see back.
 - (5) screen 30, 485-455 (length), (depth to top)
 2 1/2, PVC (size), (material)
 - (6) pump 5, 50 (HP), (yield gpm)
 elert (type power)
 - (7) electric log no (yes or no)

(organization running log)
 (8) how well bottom plugged back props.

DRILLERS REMARKS:

description of formations encountered	from	to
Clay	0	10
Sand	10	60
Sand & gravel	60	98
Blue clay	98	135
Clay & sand	135	315
Sand & clay	315	410
Sand & gravel	410	495

Miss. Board of Water Commr.

APR 4 - 1979

RECEIVED


If well telescopes please sketch and show depths.

GROUND LEVEL

140 — 4 1/2

455 — 2 1/2

455 — 2 1/2 Scr.

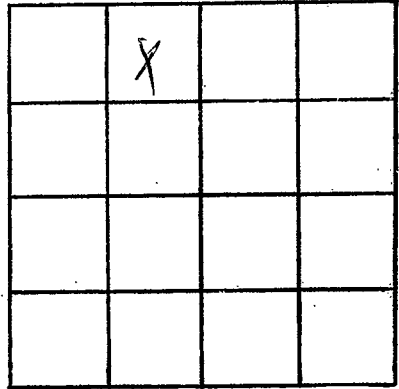

SECTION 14

Please indicate well location X.

ADDITIONAL INFORMATION

If more than one screen, show locations of each on sketch.