

MISSISSIPPI DEPARTMENT OF NATURAL RESOURCES

Bureau of Land and Water Resources

Southport Mall

P.O. Box 10631

Jackson, Mississippi 39209

WATER WELL DRILLERS LOG

CODED

WASHINGTON  
G 171

5-18 1985 Scholtz Drilling WASHINGTON  
date well completed firm name county well located

| LANDOWNER:   | description of formations encountered | from    | to        |
|--|---------------------------------------|---------|-----------|
| Dycus Fish Farms<br>Greenville, MS<br>(mailing address)  | CLAY SAND                             | 0<br>26 | 26<br>85' |
| WELL LOCATION:<br>sec. 26 T 17 N R 8 E<br>3 miles S of Greenville<br>(distance) (direction) (nearest town) |                                       |         |           |
| WELL PURPOSE: IRRIGATION<br>(home, irrigation, municipal, industrial)                                      |                                       | CODED   |           |
| WELL COMPLETION DATA:  |                                       |         |           |
| (1) diameter (inches) 16"  |                                       |         |           |
| (2) total depth (feet) 85'   |                                       |         |           |
| (3) static water level (feet) 30' below top of ground.   |                                       |         |           |
| (4) casing PVC, 65'<br>(material) (depth)  |                                       |         |           |
| _____ if telescope see back.<br>(size)   |                                       |         |           |
| (5) screen 20' 65'<br>(length) (depth to top)  |                                       |         |           |
| 16 PVC<br>(size) (material)  |                                       |         |           |
| (6) pump 20 800<br>(HP) (yield gpm)  |                                       |         |           |
| ele<br>(type power)  |                                       |         |           |
| (7) electric log NO<br>(yes or no)   |                                       |         |           |
| X<br>(organization running log)  |                                       |         |           |
| (8) how well bottom plugged CAP  |                                       |         |           |
| DRILLERS REMARKS:  |                                       |         |           |
|  |                                       |         |           |
|  |                                       |         |           |
|  |                                       |         |           |
|  |                                       |         |           |

RECEIVED


DEC 3 - 1985

Department of Natural Resources  
Bureau of Land & Water Resources

If well telescopes please sketch and show depths.

GROUND LEVEL

100

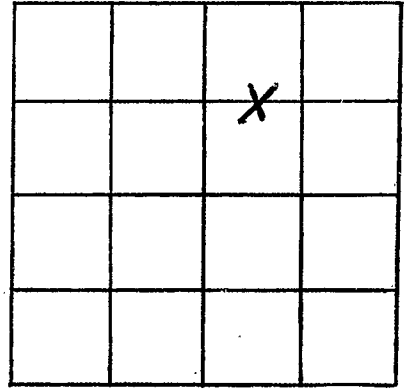

SECTION 26

Please indicate well location X.

ADDITIONAL INFORMATION

If more than one screen, show locations of each on sketch.