

MISSISSIPPI  
BOARD OF WATER COMMISSIONERS  
416 North State Street  
Jackson, Mississippi 39201

3  
CODED

WATER WELL DRILLERS LOG

2-4-81  
2-4

1981

Scholtz Drilling

Washington

date well completed

firm name

county well located

LANDOWNER:	description of formations encountered	from	to
John Cooper Bayou Road Greenville, MS (mailing address)			
<b>WELL LOCATION:</b>			
sec. <u>16</u> T. <u>17</u> N. R. <u>9</u> E <u>3</u> miles <u>SW</u> of <u>Greenville</u> (distance) (direction) (nearest town)			
<b>WELL PURPOSE:</b> <u>irrigation</u> (home, irrigation, municipal, industrial)			
<b>WELL COMPLETION DATA:</b>			
(1) diameter (inches) <u>4"</u>			
(2) total depth (feet) <u>95'</u>			
(3) static water level (feet) <u>17'</u> below top of ground.			
(4) casing <u>PVC</u> <u>65'</u> (material) (depth)			
<u>4"</u> (size) if telescope see back.			
(5) screen <u>30'</u> <u>65'</u> (length) (depth to top)			
<u>4"</u> <u>PVC slotted pipe</u> (size) (material)			
(6) pump <u>3hp</u> <u>75-</u> (HP) (yield gpm)			
<u>elc</u> (type power)			
(7) electric log <u>NO</u> (yes, or no)			
<u>Y</u> (organization/running log)			
(8) how well bottom plugged <u>b/w</u>			
<b>DRILLERS REMARKS:</b>			

DEPT. OF NATURAL RESOURCES  
BUREAU OF LAND & WATER


FEB 12 1981

RECEIVED

If well telescopes please sketch and show depths.

03000

GROUND LEVEL

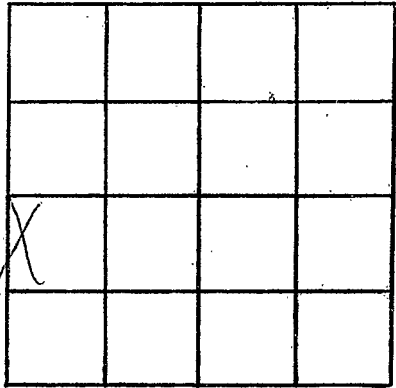

SECTION 16

Please indicate well location X.

ADDITIONAL INFORMATION

If more than one screen, show locations of each on sketch.