

Washington
G 176
 CL-1612
9/5/80

MISSISSIPPI
 BOARD OF WATER COMMISSIONERS
 416 North State Street
 Jackson, Mississippi 39201

CODED

WATER WELL DRILLERS LOG

9-5-80 19 Layne-Central Co. Washington
 date well completed firm name county well located

LANDOWNER:	description of formations encountered	from	to
Refuge Plantation	Clay	0	16
Greenville, MS	Sand	16	30
(mailing address)	Sand & P. Gravel	30	70
	Sand & Gravel	70	117
	Clay	117	

WELL LOCATION:
 sec. 21 T 17 R 8
 S N E W
6 miles S of Greenville
 (distance) (direction) (nearest town)

WELL PURPOSE: irrigation
 (home, irrigation, municipal, industrial)

WELL COMPLETION DATA:
 (1) diameter (inches) 32"
 (2) total depth (feet) 117'
 (3) static water level (feet) 16 below above top of ground.
 (4) casing Steel 67'
 (material) (depth)
16" if telescope see back.
 (size)
 (5) screen 50' 67'
 (length) (depth to top)
16" St. Steel
 (size) (material)
 (6) pump 60 2800
 (HP) (yield gpm)
electric
 (type power)
 (7) electric log no
 (yes or no)
 (organization running log)
 (8) how well bottom plugged st. plate


DRILLERS REMARKS:

DEPT. OF NATURAL RESOURCES
 BUREAU OF LAND & WATER SURVEYS

FEB 19 1981
 RECEIVED

If well telescopes please sketch and show depths.

GROUND LEVEL

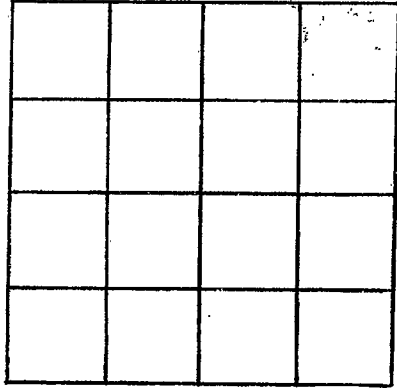

SECTION _____

Please indicate well location X.

ADDITIONAL INFORMATION

If more than one screen, show locations of each on sketch.