

MISSISSIPPI DEPARTMENT OF NATURAL RESOURCES

Bureau of Land and Water Resources

Southport Mall

P.O. Box 10631

Jackson, Mississippi 39209

WATER WELL DRILLERS LOG

**CODED**

WASHINGTON

G 178

11-19-80

335-4737

19 Nov

1980

Lambert Drilling Co Wash

date well completed

firm name

county well located

LANDOWNER:

BASF Wyandotte Corp.

Greenville, Miss.  
(mailing address)

description of formations encountered

from

to

Mixed

0 15

Sand

15 45

Sand & gravel

45 114

Clay blue

114 152

rock

152 153

Clay

153 165

Clay & sand

165 240

Sand & clay

240 360

Sand fine

360 430

Sand med to coarse

430 490

WELL LOCATION:

sec. 5 T. 17 N. R. 9 E. W. 8  
(distance) miles (direction) of (nearest town)

WELL PURPOSE: Farm Use  
(home, irrigation, municipal, industrial)


WELL COMPLETION DATA:

- (1) diameter (inches) 4x3
- (2) total depth (feet) 480
- (3) static water level (feet) 61 below above top of ground.
- (4) casing PVC 460 (material) (depth) 4x3 If telescope see back. (size)
- (5) screen 20 180-460 (length) (depth to top) 3 55 (size) (material)
- (6) pump 5 50 (HP) (yield gpm) Elect (type power)
- (7) electric log no (yes or no)  
(organization running log)

(8) how well bottom plugged back press

DRILLERS REMARKS:

**CODED**

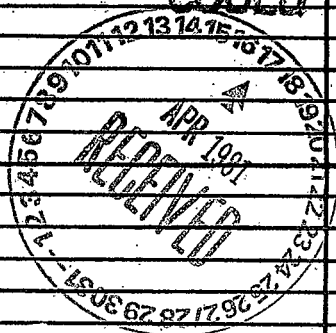

If well telescopes please sketch and show depths.

GROUND LEVEL

180

4"




460

3"

1180

3" 55  
Screen

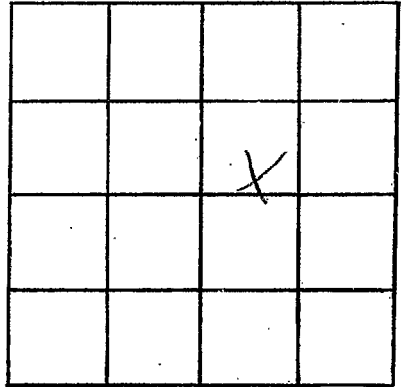

SECTION 5

Please indicate well location X.

ADDITIONAL INFORMATION

If more than one screen,  
show locations of each on sketch.