

MISSISSIPPI DEPARTMENT OF NATURAL RESOURCES

Bureau of Land and Water Resources

Southport Mall

P.O. Box 10631

Jackson, Mississippi 39209


WATER WELL DRILLERS LOG

RODED

Washington  
G 179  
2-15-81

15 Feb 1981 Lambert Drilling WASH  
 date well completed firm name county well located

LANDOWNER:	description of formations encountered	from	to
<u>M/De Cordell</u> <u>Lake Lee</u> <u>Greenville, Miss.</u> (mailing address)			
WELL LOCATION:	<u>Clay</u>	<u>15</u>	<u>35</u>
sec. <u>13</u> T. <u>17</u> N. R. <u>9</u> E <u>9</u> miles <u>S/W</u> of <u>River</u> (distance) (direction) (nearest town)	<u>Sand Pine</u>	<u>35</u>	<u>90</u>
WELL PURPOSE: <u>name</u> (home, irrigation, municipal, industrial)	<u>Pea gravel</u>	<u>90</u>	<u>120</u>
WELL COMPLETION DATA:	<u>blue shell</u>	<u>120</u>	<u>165</u>
(1) diameter (inches) <u>4 1/2</u>	<u>Clay</u>	<u>165</u>	<u>240</u>
(2) total depth (feet) <u>435</u>	<u>Clay st Sand</u>	<u>240</u>	<u>340</u>
(3) static water level (feet) <u>48</u> below above top of ground.	<u>Sand Pine</u>	<u>340</u>	<u>410</u>
(4) casing <u>PVC</u> , <u>425</u> (material) (depth)	<u>Sand, coarse</u>	<u>410</u>	<u>440</u>
<u>4 1/2</u> if telescope see back. (size)			
(5) screen <u>10</u> , <u>435-425</u> (length) (depth to top)			
<u>2</u> , <u>55</u> (size) (material)			
(6) pump <u>1</u> , <u>20</u> (HP) (yield gpm)			
<u>elect</u> (type power)			
(7) electric log (yes or no)			
(organization running log)			
(8) how well bottom plugged <u>back press.</u>			

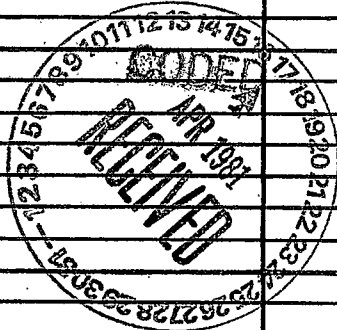

DRILLERS REMARKS:

If well telescopes please sketch and show depths.

GROUND LEVEL

140 4"

425 2"

435 2" screen

X			

SECTION 9

Please indicate well location X.

ADDITIONAL INFORMATION

If more than one screen, show locations of each on sketch.