

MISSISSIPPI DEPARTMENT OF NATURAL RESOURCES

Bureau of Land and Water Resources

Southport Mall

P.O. Box 10631

Jackson, Mississippi 39209

WATER WELL DRILLERS LOG


**CODED**

WASHINGTON  
G-180  
1-13-81

13 Jan 1981 Lambert Drilling Wash  
date well completed firm name county well located

LANDOWNER:	description of formations encountered	from	to
Ed Engels Lake Lee Greenville, Miss. (mailing address)			
WELL LOCATION: sec. 18 T 17 N R 9 E 9 miles S/W of Green (distance) (direction) (nearest town)	Clay	0	30
WELL PURPOSE: home (home, irrigation, municipal, industrial)	Sand	30	55
WELL COMPLETION DATA:	Sand & gravel	55	105
(1) diameter (inches) 4x2	Clay blue shell	105	270
(2) total depth (feet) 405	Clayst. Sand	270	330
(3) static water level (feet) 42 below top of ground.	Sandst. clay	330	345
(4) casing PVC, 395. (material) (depth)	Sand, med.	345	390
4x2 (size) If telescope see back.	Sand, coarse	390	410
(5) screen 10, 405-395 (length) (depth to top)			
2" (size), 55 (material)			
(6) pump 1, 20 (HP) (yield gpm)			
elect (type power)			
(7) electric log no. (yes or no)			
for (organization running log)			
(8) how well bottom plugged back press.			

**CODED**

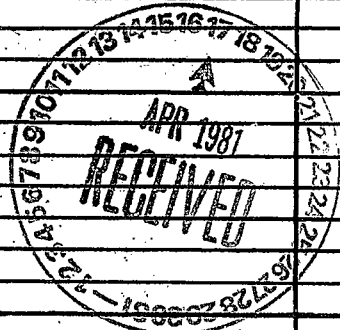

DRILLERS REMARKS:


If well telescopes please sketch and show depths.

GROUND LEVEL

140 4''

395 2''

405 2'' screen

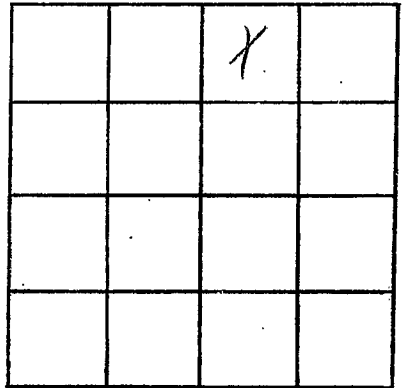

SECTION 9

Please indicate well location X.

ADDITIONAL INFORMATION

If more than one screen, show locations of each on sketch.