




If well telescopes please sketch and show depths.

GROUND LEVEL

140 4"

462 2"

492 2" screen

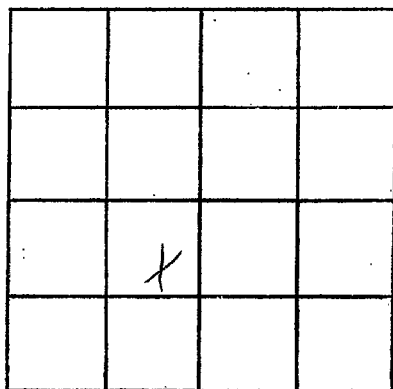

SECTION 8

Please indicate well location X.

ADDITIONAL INFORMATION

If more than one screen, show locations of each on sketch.