

Bureau of Land and Water Resources

Southport Mall

P.O. Box 10631

0021

Jackson, Mississippi 39209

WATER WELL DRILLERS LOG

1/29/81

date well completed

Dyer

firm name

Washington

county well located

LANDOWNER:

HUNTER MOORE HEAD

Greenville, MS

(mailing address)

WELL LOCATION:

sec. 32 T. 12 N. R. 8 E. S. 1
1 miles S of Greenville
(distance) (direction) (nearest town)

WELL PURPOSE:

(home, irrigation, municipal, industrial)

WELL COMPLETION DATA:

- (1) diameter (inches) 16"
- (2) total depth (feet) 95'
- (3) static water level (feet) 22 below top of ground.
- (4) casing Steel 95' (material) (depth)
16" (size) if telescopic - see back.
- (5) screen 40' 55' (length) (depth to top)
16" Steel (size) (material)
- (6) pump 60 7000 (HP) (yield gpm)
Diesel (type power)
- (7) electric log (yes or no)

(organization running log)

(8) how well bottom plugged plate

DRILLERS REMARKS:

description of formations encountered


CODED


from

to

Clay	0	35
Sand	35	45
Sand + Gravel	45	55
Sand	55	65
Sand + Gravel	65	95

CODED

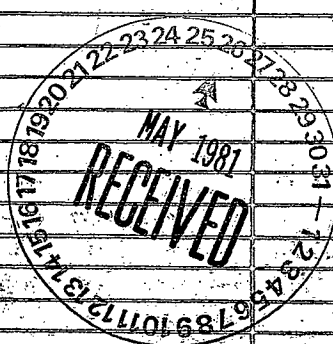

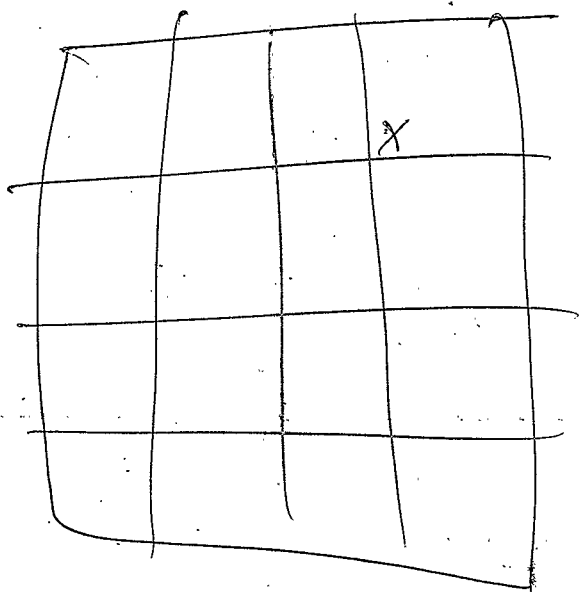

Sec 37