

MISSISSIPPI DEPARTMENT OF NATURAL RESOURCES

Bureau of Land and Water Resources

Southport Mall

P.O. Box 10631

Jackson, Mississippi 39209

WATER WELL DRILLERS LOG

CODED

WASHINGTON
G 186
7-8-81

8 July 1981 Lambert Drilling West
date well completed firm name county well located

LANDOWNER:	description of formations encountered	from	to
(mailing address)			
Boat Hercules Chem. Co. Herculesville, Miss.	Mixed	0	15
WELL LOCATION: sec. 25 T 17 N R 9 E 1.0 miles SW of Brown (distance) (direction) (nearest town)	Clay	15	30
WELL PURPOSE: Farm (home, irrigation, municipal, industrial)	Sand	30	85
WELL COMPLETION DATA:	Pea gravel	85	110
(1) diameter (inches) 4 1/2	Clay	110	205
(2) total depth (feet) 440	Clay sand	205	380
(3) static water level (feet) 42 below top of ground.	Sand	380	440
(4) casing PVC 420 (material) (depth) 4 1/2 (size) If telescope see back.			
(5) screen 20 440-420 (length) (depth to top) 2" (size) 85 (material)			
(6) pump 1/2 28 (HP) (yield gpm) elect (type power)			
(7) electric log NO (yes or no) (organization running log)			
(8) how well bottom plugged: back plug.			

DEPT. OF NATURAL RESOURCES
BUREAU OF LAND & WATER RESOURCES

SEP 16 1981

RECEIVED

DRILLERS REMARKS:


If well telescopes please sketch and show depths.

GROUND LEVEL

140 4''

420 2''

440 2'' SS,

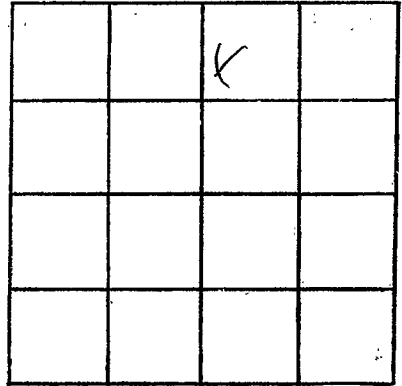

SECTION 25

Please indicate well location X.

ADDITIONAL INFORMATION

If more than one screen, show locations of each on sketch.