

MISSISSIPPI DEPARTMENT OF NATURAL RESOURCES
 Bureau of Land and Water Resources
 Southport Mall
 P.O. Box 10631
 Jackson, Mississippi 39219
WATER WELL DRILLERS LOG

WASHINGTON
G 188
8-13-81

CODED

8-13 1981 IRRIGATION SUPPLY Co. Washington
 date well completed firm name county well located

LANDOWNER:	description of formations encountered	from	to
<u>Ared BALLARD</u>	<u>TOP SOIL CLAY</u>	<u>0</u>	<u>10</u>
<u>Rt 1</u>	<u>CLAY</u>	<u>10</u>	<u>20</u>
<u>LELAND, ms 38756</u>	<u>CLAY</u>	<u>20</u>	<u>30</u>
(mailing address)	<u>fine Sand</u>	<u>30</u>	<u>40</u>
WELL LOCATION:	<u>" "</u>	<u>40</u>	<u>50</u>
<u>sec. 32 T. 17 N. S. R. 8 E. W.</u>	<u>fine & coarse Sand</u>	<u>50</u>	<u>60</u>
<u>10</u> miles <u>S</u> of <u>G'VILLE</u>	<u>COARSE SAND & GRAVEL</u>	<u>60</u>	<u>70</u>
(distance) (direction) (nearest town)	<u>" "</u>	<u>70</u>	<u>80</u>
WELL PURPOSE: <u>FISH PONDS</u>	<u>Clay Bottom</u>	<u>80</u>	
(home, irrigation, municipal, industrial)			

WELL COMPLETION DATA:

(1) diameter (inches) 8"

(2) total depth (feet) 80'

(3) static water level (feet) 25' below above top of ground.

(4) casing PVC, 60',
 (material) (depth)
 _____ If telescope see back.
 (size)

(5) screen 20', 60'
 (length) (depth to top)
8", PVC
 (size) (material)

(6) pump 15, 600
 (HP) (yield gpm)
Elect.
 (type power)

(7) electric log No
 (yes or no)

 (organization running log)

(8) how well bottom plugged _____
PVC CAP

DRILLERS REMARKS: _____


DEPT. OF NATURAL RESOURCES
 BUREAU OF LAND & WATER RESOURCES

SEP 15 1981

RECEIVED

If well telescopes please sketch and show depths.

GROUND LEVEL

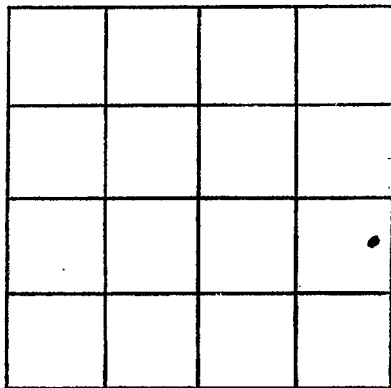

SECTION 37

Please indicate well location X.

ADDITIONAL INFORMATION

If more than one screen, show locations of each on sketch.

