

WASHINGTON
G 189
8-13-81

MISSISSIPPI DEPARTMENT OF NATURAL RESOURCES
Bureau of Land and Water Resources
Southport Mall
P.O. Box 10631
Jackson, Mississippi 39209
WATER WELL DRILLERS LOG

CODED

8-13 1981 IRRIGATION SUPPLY Co. WASHINGTON
date well completed firm name county well located

LANDOWNER:	description of formations encountered	from	to
J. Red BALLARD RT. 1	TOP SOIL CLAY	0	10
LELAND, MS 38256 (mailing address)	CLAY	10	20
WELL LOCATION:	CLAY	20	30
sec. 32 T 17 N R 8 E S W	FINE SAND	30	40
1/2 miles S of G'VILLE (distance) (direction) (nearest town)	FINE & COARSE SAND	40	50
WELL PURPOSE: FISH PONDS (home, irrigation, municipal, industrial)	COARSE SAND-GRAVEL	60	70
WELL COMPLETION DATA:	" " "	70	80
(1) diameter (inches) 8"	Clay Bottom	80	
(2) total depth (feet) 80'	COVER		
(3) static water level (feet) 25' below top of ground.			
(4) casing PVC, 60' (material) (depth)			
(size) If telescope see back.			
(5) screen 20', 60' (length) (depth to top)			
8" PVC (size) (material)			
(6) pump 15 HP, 600 (HP) (yield gpm)			
Elect. (type power)			
(7) electric log No (yes or no)			
(organization running log)			
(8) how well bottom plugged PVC CAP			
DRILLERS REMARKS:			


DEPT. OF NATURAL RESOURCES
BUREAU OF LAND & WATER RESOURCES

SEP 15 1981

RECEIVED

If well telescopes please sketch and show depths.

GROUND LEVEL

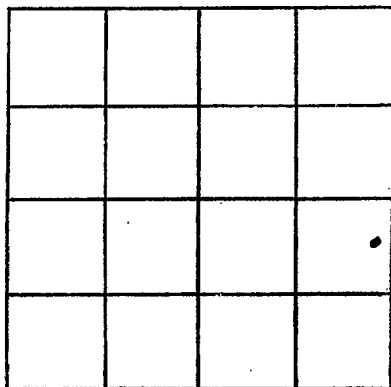

SECTION 37

Please indicate well location X.

ADDITIONAL INFORMATION

If more than one screen,
show locations of each on sketch.

