

MISSISSIPPI DEPARTMENT OF NATURAL RESOURCES

Bureau of Land and Water Resources

Southport Mall

P.O. Box 10631

Jackson, Mississippi 39209

WATER WELL DRILLERS LOG

CODED

CL-1817  
Washington  
G 191  
4-22-81

4-22-81

19

LAYNE-CENTRAL COMPANY

WASHINGTON

date well completed

firm name

county well located

LANDOWNER:	description of formations encountered	from	to
Homewood Farms	clay	0	35
Greenville, MS (mailing address)	coarse sand	35	42
	coarse sand	42	52
	coarse sand & gravel	52	62
	coarse sand & gravel	62	82
	clay	82	84
<b>WELL LOCATION:</b>			
sec. <u>17</u> T. <u>17</u> N R. <u>8</u> E			
<div style="display: flex; justify-content: space-around;"> <span><u>0.4</u> miles (distance)</span> <span><u>E</u> (direction)</span> <span><u>SUBJECT WATER</u> (nearest town)</span> </div>			
<b>WELL PURPOSE:</b> irrigation (home, irrigation, municipal, industrial)			
<b>WELL COMPLETION DATA:</b>			
(1) diameter (inches)	28"		
(2) total depth (feet)	84'		
(3) static water level (feet)	20'9" <sup>below</sup> / <sub>above</sub> top of ground.		
(4) casing (material)	steel 54' (depth)		
(4) casing (size)	16" If telescope see back.		
(5) screen (length)	30' 54' (depth to top)		
(5) screen (size)	12" st. steel (material)		
(6) pump (HP)	30 <del>HP</del> 1000 (yield gpm)		
(6) pump (type power)	<u>Direct Electric</u>		
(7) electric log (yes or no)	no		
(7) electric log (organization running log)			
(8) how well bottom plugged	st. plate		
DRILLERS REMARKS:			


CODED

DEPT. OF NATURAL RESOURCES  
 BUREAU OF LAND & WATER RESOURCES

OCT 20 1981  
 RECEIVED

If well telescopes please sketch and show depths.

GROUND LEVEL

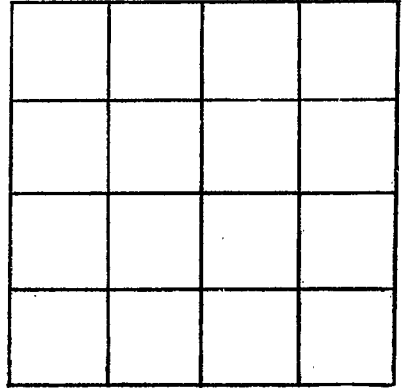

SECTION \_\_\_\_\_

Please indicate well location X.

ADDITIONAL INFORMATION

If more than one screen, show locations of each on sketch.