

MISSISSIPPI DEPARTMENT OF NATURAL RESOURCES

Bureau of Land and Water Resources

Southport Mall

P.O. Box 10631

Jackson, Mississippi 39209

WATER WELL DRILLERS LOG

CODED

WASHINGTON
 5198
 5-7-82
 Elog # 101

760009-02

82 Schultz Drilling

Washington

date well completed

firm name

county well located

LANDOWNER:	description of formations encountered	from	to
Swiftwater Water Assoc. Greenville MS (mailing address)			
WELL LOCATION: sec. 13 T. 17 N. R. 8 E. S. 6 W. 6 miles S of Greenville (distance) (direction) (nearest town)			
WELL PURPOSE: municipal (home, irrigation, municipal, industrial)			
WELL COMPLETION DATA:			
(1) diameter (inches) 4"			
(2) total depth (feet) 430'			
(3) static water level (feet) 29' below top of ground.			
(4) casing PVC 390' (material) (depth)			
(size) If telescope see back.			
(5) screen 40' 390' (length) (depth to top)			
4" PVC Weapped (size) (material)			
(6) pump 5 85 (HP) (yield gpm)			
Etc. (type power)			
(7) electric log yes (yes or no) MDNR, state (organization running log)			
(8) how well bottom plugged b/w			


CODED

DEPT. OF NATURAL RESOURCES
 BUREAU OF LAND & WATER RESOURCES

MAY 14 1982
 RECEIVED

DRILLERS REMARKS:

If well telescopes please sketch and show depths.

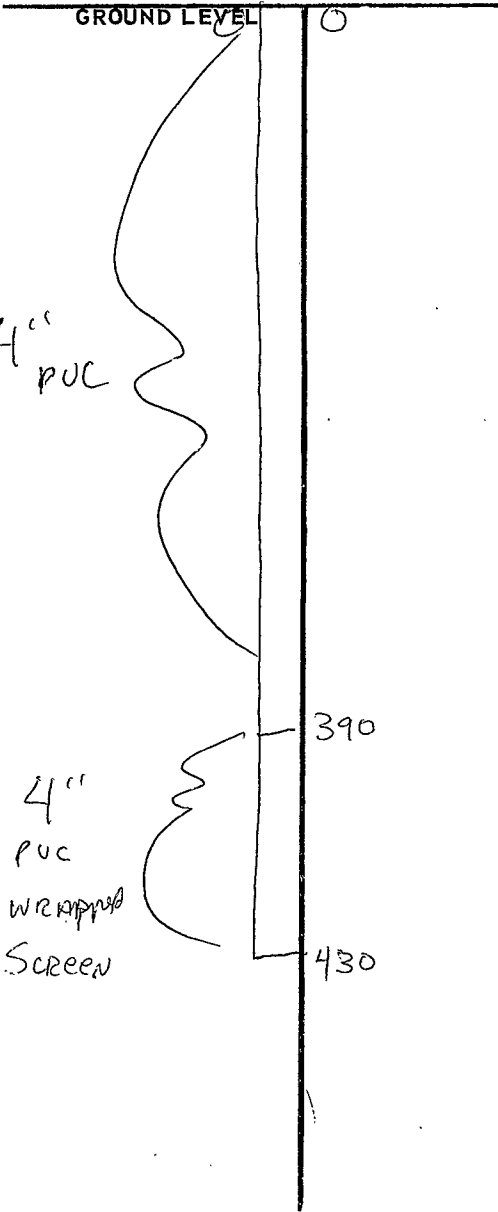

			X

SECTION _____

Please indicate well location X.

ADDITIONAL INFORMATION

If more than one screen, show locations of each on sketch.