

MISSISSIPPI DEPARTMENT OF NATURAL RESOURCES
Bureau of Land and Water Resources
 Southport Mall
 P.O. Box 10631
 Jackson, Mississippi 39209
WATER WELL DRILLERS LOG

Washington
G 203
5-2-83

5-2 1983 Schultz Drilling Washington
 date well completed firm name county well located

LANDOWNER:
AQUA FARMS
Greenville MS
 (mailing address)

description of formations encountered	from	to
	CLAY SAND	0
SAND + Pea GRAVEL	30	60
	30	90

WELL LOCATION:
 sec. 29 T. 17 S. R. 8 E.
8 miles SE of Greenville
 (distance) (direction) (nearest town)

WELL PURPOSE: IRRIGATION
 (home, irrigation, municipal, industrial)

- WELL COMPLETION DATA:**
- (1) diameter (inches) 10"
- (2) total depth (feet) 90'
- (3) static water level (feet) 20' below/above top of ground.
- (4) casing PVC, 60' (material) (depth)
10" (size) if telescope see back.
- (5) screen 10", 60' (length) (depth to top)
10" (size) PVC (material)
- (6) pump 20 900 (HP) (yield gpm)
EIE (type power)
- (7) electric log NO (yes or no)
X (organization running log)
- (8) how well bottom plugged CAP

CODED


DEPT. OF NATURAL RESOURCES
 BUREAU OF LAND & WATER RESOURCES
 JUN - 2 1983

DRILLERS REMARKS: 3

RECEIVED

If well telescopes please sketch and show depths.

GROUND LEVEL

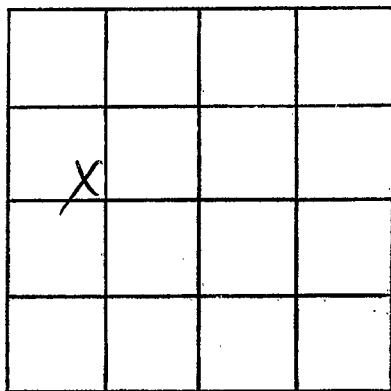

SECTION 29

Please indicate well location X.

ADDITIONAL INFORMATION

If more than one screen,
show locations of each on sketch.