

MISSISSIPPI DEPARTMENT OF NATURAL RESOURCES

Bureau of Land and Water Resources

Southport Mall

P.O. Box 10631 **CODED**

Jackson, Mississippi 39209

**WATER WELL DRILLERS LOG**

G-205  
12/23/83  
Washington

12/19/83  
date well completed

19 Curtis Irrigation  
firm name

Washington  
county well located

LANDOWNER:  
DR. ROBERT SWARES  
GREENVILLE, MISS.  
(mailing address)

WELL LOCATION:  
sec. 11 T. 17 N. R. 8 E. S. 5  
2 miles N of GREENVILLE  
(distance) (direction) (nearest town)

WELL PURPOSE: Home  
(home) irrigation, municipal, industrial

WELL COMPLETION DATA:

- (1) diameter (inches) 4" x 3"
- (2) total depth (feet) 530
- (3) static water level (feet) 20 <sup>below</sup> <sub>above</sub> top of ground.
- (4) casing 4" PVC 0-140 (material) (depth)  
3" PVC 140-370  
(size) if telescope see back.
- (5) screen 2 1/2" x 3" - 370 (length) (depth to top)  
3" (size) Stainless Steel (material)
- (6) pump 3 H.P. (HP) 50 (yield gpm)
- Electric (type power)
- (7) electric log #107 (yes or no)  
Bureau of Geology (organization running log)
- (8) how well bottom plugged End

description of formations encountered	from	to
Top Soil & Clay	0	10
Clay	10	15
Sand	15	20
Sand	20	40
Sand	40	50
Sand	50	60
Sand	60	70
Sand	70	75
Sand & Gravel	75	85
Clay	83	100
Clay	100	120
Clay & Rock	120	140
Clay & Rock	140	160
Clay	160	180
Clay	180	200
Clay	200	220
Clay	220	240
Clay	240	260
Clay	260	272
Rock	272	273
Clay	273	280
Clay	300	320
Clay	320	340
Clay	340	360
Clay	360	380
Clay & Sand	380	560

Set at 530 ft


**RECEIVED**  
MAR 14 1985

DRILLERS REMARKS:

Department of Natural Resources  
Bureau of Land & Water Resources

If well telescopes please sketch and show depths.

GROUND LEVEL

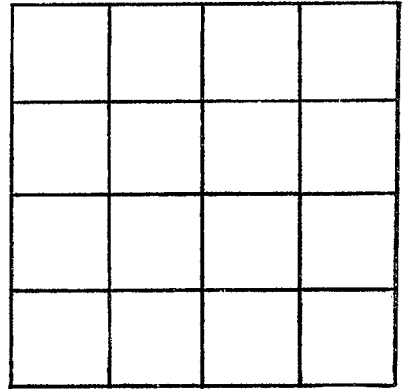

SECTION \_\_\_\_\_

Please indicate well location X.

ADDITIONAL INFORMATION

If more than one screen,  
show locations of each on sketch.