

MISSISSIPPI DEPARTMENT OF NATURAL RESOURCES

Bureau of Land and Water Resources

Southport Mall

P.O. Box 10631

Jackson, Mississippi 39209

WATER WELL DRILLERS LOG

CODED

(Well #1) G. 206
 WASHINGTON CO
 3-30-84

3/30 1984 Schultz Drilling WASHINGTON
 date well completed firm name county well located

LANDOWNER: Gene A. Clements
 24 Abide Drive
 Greenville, MS
 (mailing address)

description of formations encountered	from	to
CLAY	0	38
COARSE SAND	38	45
COARSE SAND and PEA GRAVEL	45	70
COARSE SAND and GRAVEL	70	97
CLAY	97	

WELL LOCATION:
 sec. 28 T. 18 N. R. 8 E.
 2 miles S of Greenville
 (distance) (direction) (nearest town)

WELL PURPOSE: IRRIGATION
 (home, irrigation, municipal, industrial)

WELL COMPLETION DATA:

- (1) diameter (inches) 16"
- (2) total depth (feet) 97'
- (3) static water level (feet) 18' below top of ground.
- (4) casing PVC 57' (material) (depth)
- (5) screen 40' 57' (length) (depth to top)
 16" PVC (size) (material)
- (6) pump 50 2500 (HP) (yield gpm)
 dc (type power)
- (7) electric log NO (yes or no)
- (8) how well bottom plugged PVC CAP

CODED

DRILLERS REMARKS:


DEPT. OF NATURAL RESOURCES
 BUREAU OF LAND & WATER RESOURCES

APR 23 1984

RECEIVED

If well telescopes please sketch and show depths.

GROUND LEVEL

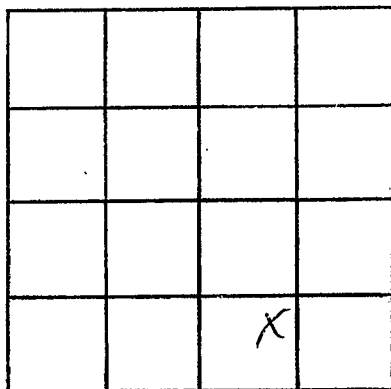

SECTION 28

Please indicate well location X.

ADDITIONAL INFORMATION

If more than one screen,
show locations of each on sketch.