

MISSISSIPPI DEPARTMENT OF NATURAL RESOURCES

Bureau of Land and Water Resources

Southport Mall

P.O. Box 10631

Jackson, Mississippi 39209

WATER WELL DRILLERS LOG

CODED

(Well #2) G 207

WASHINGTON CO.

3-31-84

3-31

1984

Schultz Drilling

Washington

date well completed

firm name

county well located

LANDOWNER: Gene A. Clements

description of formations encountered

from

to

24. Abide Drive

Greenville MS

(mailing address)

Clay	0	26
COARSE SAND	26	40
COARSE SAND +	40	60
PEA GRAVEL		
COARSE SAND +	60	82
GRAVEL		
CLAY	82	

WELL LOCATION:

sec. 37 T 18 N R 8 E
S W
2 miles SE of Greenville
(distance) (direction) (nearest town)

WELL PURPOSE: IRRIGATION
(home, irrigation, municipal, industrial)

WELL COMPLETION DATA:

- (1) diameter (inches) 16"
- (2) total depth (feet) 82'
- (3) static water level (feet) 18' below above top of ground.
- (4) casing PVC 42'
(material) (depth)
- (size) if telescope see back.
- (5) screen 40' 42'
(length) (depth to top)
16" PVC
(size) (material)
- (6) pump 50 2000
(HP) (yield gpm)
- power unit
(type power)
- (7) electric log NO
(yes or no)

(organization running log)

(8) how well bottom plugged PVC CAP

DRILLERS REMARKS:

CODED


DEPT. OF NATURAL RESOURCES
BUREAU OF LAND & WATER RESOURCES

APR 23 1984

RECEIVED

If well telescopes please sketch and show depths.

GROUND LEVEL

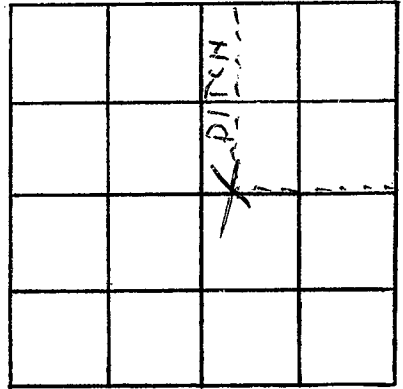

SECTION 37

Please indicate well location X.

ADDITIONAL INFORMATION

If more than one screen,
show locations of each on sketch.