

MISSISSIPPI DEPARTMENT OF NATURAL RESOURCES

Bureau of Land and Water Resources

Southport Mall

P.O. Box 10631

Jackson, Mississippi 39209

WATER WELL DRILLERS LOG

COBED

(Well #3) G 208  
 WASHINGTON CO.  
 3-31-84

3-31 1984 Schultz Drilling Washington  
 date well completed firm name county well located

LANDOWNER: Gene A. Clements  
 24 ABIDE Drive  
 Greenville MS  
 (mailing address)

description of formations encountered

from to

CLAY	0	21
FINE SAND	21	30
COARSE SAND	30	55
COARSE SAND + PER GRAVEL	55	96

WELL LOCATION:

sec. 37 T 18 N R 8 E  
 S W  
 2 miles SE of Greenville  
 (distance) (direction) (nearest town)

WELL PURPOSE: irrigation  
 (home, irrigation, municipal, industrial)

WELL COMPLETION DATA:

- (1) diameter (inches) 16"
- (2) total depth (feet) 96'
- (3) static water level (feet) 18' below above top of ground.
- (4) casing PVC, 56'  
 (material) (depth)  
 (size) if telescope see back.
- (5) screen 40', 56'  
 (length) (depth to top)  
16" PVC  
 (size) (material)
- (6) pump 50 2500  
 (HP) (yield gpm)  
elb  
 (type power)
- (7) electric log NO  
 (yes or no)

(organization running log)

(8) how well bottom plugged PVC CAP

DRILLERS REMARKS:

COBED


DEPT. OF NATURAL RESOURCES  
 BUREAU OF LAND & WATER RESOURCES

APR 23 1984

RECEIVED

If well telescopes please sketch and show depths.

GROUND LEVEL

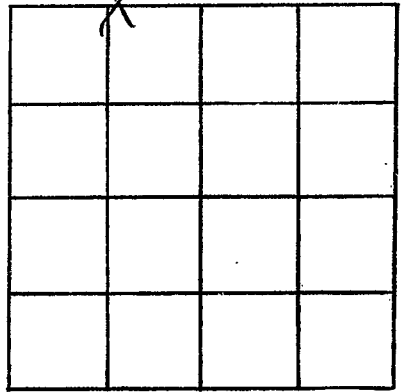

SECTION \_\_\_\_\_

Please indicate well location X.

ADDITIONAL INFORMATION

If more than one screen, show locations of each on sketch.