

MISSISSIPPI DEPARTMENT OF NATURAL RESOURCES

Bureau of Land and Water Resources

Southport Mall

P.O. Box 10631

Jackson, Mississippi 39209

WATER WELL DRILLERS LOG

CODED

GZ10
WASHINGTON
4-25-84

4-25-84 date well completed Schultz Drilling firm name Washington county well located

LANDOWNER: Gene Allen Clements
Abide Drive
Greenville, MS
(mailing address)

description of formations encountered

from

to

| | | |
|------------------------------|----|----|
| CLAY | 0 | 50 |
| COARSE SAND | 50 | 60 |
| COARSE SAND + PEA GRAVEL. | 60 | 93 |

WELL LOCATION:
sec. 10 T 17 N R 8 E
2 miles S of Greenville
(distance) (direction) (nearest town)

WELL PURPOSE: IRRIGATION
(home, irrigation, municipal, industrial)

- WELL COMPLETION DATA:
- (1) diameter (inches) 16"
 - (2) total depth (feet) 93'
 - (3) static water level (feet) 10' below top of ground.
 - (4) casing PVC 53' (material) (depth)
 - (5) screen 40' 53' (length) (depth to top)
16" (size) PVC (material)
 - (6) pump 30 2000 (HP) (yield gpm)
de (type power)
 - (7) electric log NO (yes or no)
(organization running log)
 - (8) how well bottom plugged PVC CAP

DEPT. OF NATURAL RESOURCES
BUREAU OF LAND & WATER RESOURCES


APR 27 1984

RECEIVED

DRILLERS REMARKS:

If well telescopes please sketch and show depths.

GROUND LEVEL

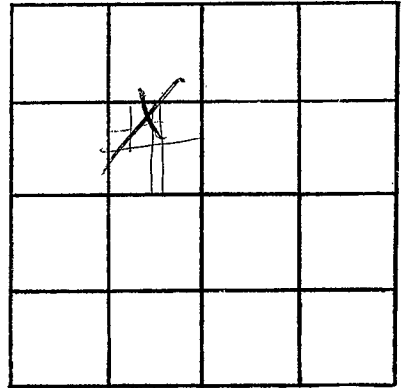

SECTION 10

Please indicate well location X.

ADDITIONAL INFORMATION

If more than one screen,
show locations of each on sketch.