

**MISSISSIPPI DEPARTMENT OF NATURAL RESOURCES**  
**Bureau of Land and Water Resources**  
 Southport Mall  
 P.O. Box 10631  
 Jackson, Mississippi 39209  
**WATER WELL DRILLERS LOG**

G211  
~~EL-2649~~ WASHINGTON  
3-1-84

**COBED**

3-1 1984 LAYNE CENTRAL CO. WASHINGTON  
 date well completed firm name county well located

LANDOWNER:	description of formations encountered	from	to
VLASIC FOODS GREENVILLE, MS 38701 (mailing address)			
WELL LOCATION: sec. <u>4</u> T. <u>17</u> N. R. <u>9</u> W. <u>4</u> miles S of <u>GREENVILLE</u> (distance) (direction) (nearest town)	sand	26	57
	coarse sand	57	95
	coarse sand & pea gravel	95	121
	hard clay	121	136
	clay	136	176
	sandy clay & stk. of sand	176	295
	clay	295	345
	sandy clay	345	367
	fine sand (cut bad)	367	376
	sand	376	438
WELL PURPOSE: <u>INDUSTRIAL</u> (home, irrigation, municipal, industrial)			
WELL COMPLETION DATA:			
(1) diameter (inches) <u>15"</u>			
(2) total depth (feet) <u>438' 9"</u>			
(3) static water level (feet) <u>41'</u> below top of ground.			
(4) casing <u>steel</u> , <u>372'</u> (material) (depth) <u>10"</u> (size) If telescope see back.			
(5) screen <u>60' 9"</u> , <u>312'</u> (length) (depth to top) <u>6"</u> st. steel (size) (material)			
(6) pump <u>60</u> , <u>600</u> (HP) (yield gpm) electric (type power)			
(7) electric log <u>yes</u> (yes or no) <u>Layne</u> (organization running log)			
(8) how well bottom plugged <u>6" BP valve</u>			
DRILLERS REMARKS:			


DEPT. OF NATURAL RESOURCES  
 BUREAU OF LAND & WATER RESOURCES

**MAY 17 1984**

**RECEIVED**

If well telescopes please sketch and show depths.

GROUND LEVEL

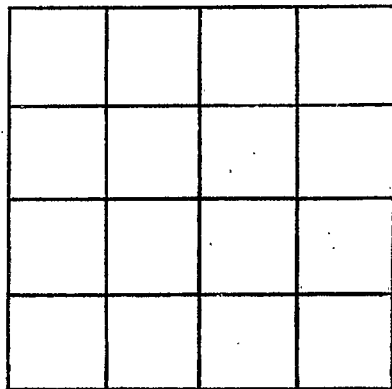

SECTION \_\_\_\_\_

Please indicate well location X.

ADDITIONAL INFORMATION

If more than one screen, show locations of each on sketch.