

MISSISSIPPI DEPARTMENT OF NATURAL RESOURCES

Bureau of Land and Water Resources

Southport Mall

P.O. Box 10631

Jackson, Mississippi 39209

WATER WELL DRILLERS LOG

CODED

WASHINGTON  
G 212  
GW - 05668

33 19 36  
91 03 42

7-2 1984 Schultz Drilling Washington  
date well completed firm name county well located

LANDOWNER:	description of formations encountered	from	to
Bell Plantation Greenville MS. (mailing address)			
WELL LOCATION: sec. 23 T 17 N R 9 E 4 miles S of Greenville (distance) (direction) (nearest town)			
WELL PURPOSE: IRRIGATION (home, irrigation, municipal, industrial)			
WELL COMPLETION DATA:			
(1) diameter (inches) 10"			
(2) total depth (feet) 90'			
(3) static water level (feet) 28' below top of ground.			
(4) casing PVC 60' (material) (depth)			
(5) screen 30' 60' (length) (depth to top) 10" PVC (size) (material)			
(6) pump 20 1000 (HP) (yield gpm) elb (type power)			
(7) electric log NO (yes or no) (organization running log)			
(8) how well bottom plugged PVC CAP			
DRILLERS REMARKS:			

CODED


DEPT. OF NATURAL RESOURCES  
BUREAU OF LAND & WATER RESOURCES

NOV 26 1984

RECEIVED

If well telescopes please sketch and show depths.

GROUND LEVEL

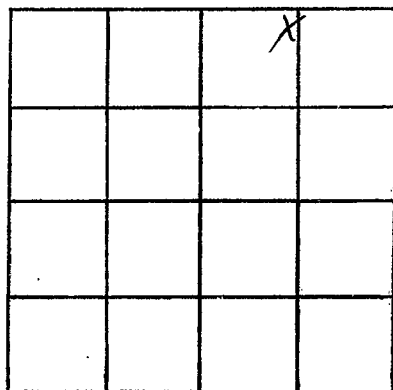

SECTION 23

Please indicate well location X.

ADDITIONAL INFORMATION

If more than one screen,  
show locations of each on sketch.