

WASHINGTON
G213

MISSISSIPPI DEPARTMENT OF NATURAL RESOURCES

Bureau of Land and Water Resources

Southport Mall

P.O. Box 10631

Jackson, Mississippi 39209

WATER WELL DRILLERS LOG

CODED

7-9-84 date well completed
1984 Schultz Drilling firm name
Washington county well located

| LANDOWNER: | description of formations encountered | from | to |
|--|---------------------------------------|------|----|
| Paul WATSON | CLAY | 0 | 21 |
| Greenville MS (mailing address) | MED. SAND | 21 | 36 |
| WELL LOCATION: sec. 36 T 17 N R 8 E 5 miles S of Greenville (distance) (direction) (nearest town) | COARSE SAND + PEA GRAVEL | 36 | 80 |
| WELL PURPOSE: IRRIGATION (home, irrigation, municipal, industrial) | | | |
| WELL COMPLETION DATA: | | | |
| (1) diameter (inches) 10" | | | |
| (2) total depth (feet) 80' | | | |
| (3) static water level (feet) 31' below top of ground. | | | |
| (4) casing PVC 60' (material) (depth) | | | |
| (size) if telescope see back. | | | |
| (5) screen 20' 60' (length) (depth to top) | | | |
| 10" PVC (size) (material) | | | |
| (6) pump 20 1000 (HP) (yield gpm) | | | |
| elo (type power) | | | |
| (7) electric log NO (yes or no) | | | |
| (organization running log) | | | |
| (8) how well bottom plugged PVC CAP | | | |
| DRILLERS REMARKS: | | | |

CODED


DEPT. OF NATURAL RESOURCES
BUREAU OF LAND & WATER RESOURCES

NOV 26 1984

RECEIVED

If well telescopes please sketch and show depths.

GROUND LEVEL

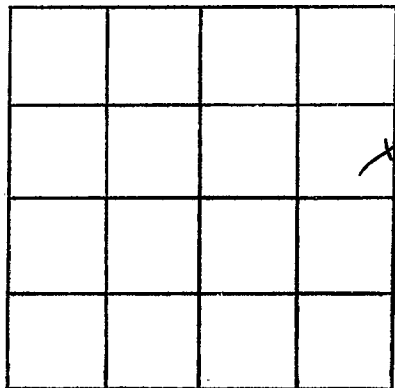

SECTION 36

Please indicate well location X.

ADDITIONAL INFORMATION

If more than one screen,
show locations of each on sketch.